



WAN	
CIRCUIT ID	KXIP300434
IP ADDRESS	10.227.226.1

"PLATFORM 1 HP ISDN"
01-256-896326
"PLATFORM 2 HP ISDN"
01-256-896327

All Equipment tags to be prefixed with "WCH-"

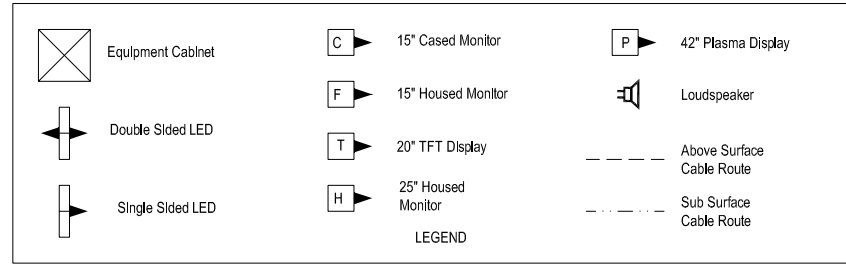


Equipment	Dist Board
CIS RACK	CCT NO. 2
TOF-CIDU-001	CCT NO. 1
TH-CIDU-002	CCT NO.1
HEATER	CCT NO.3

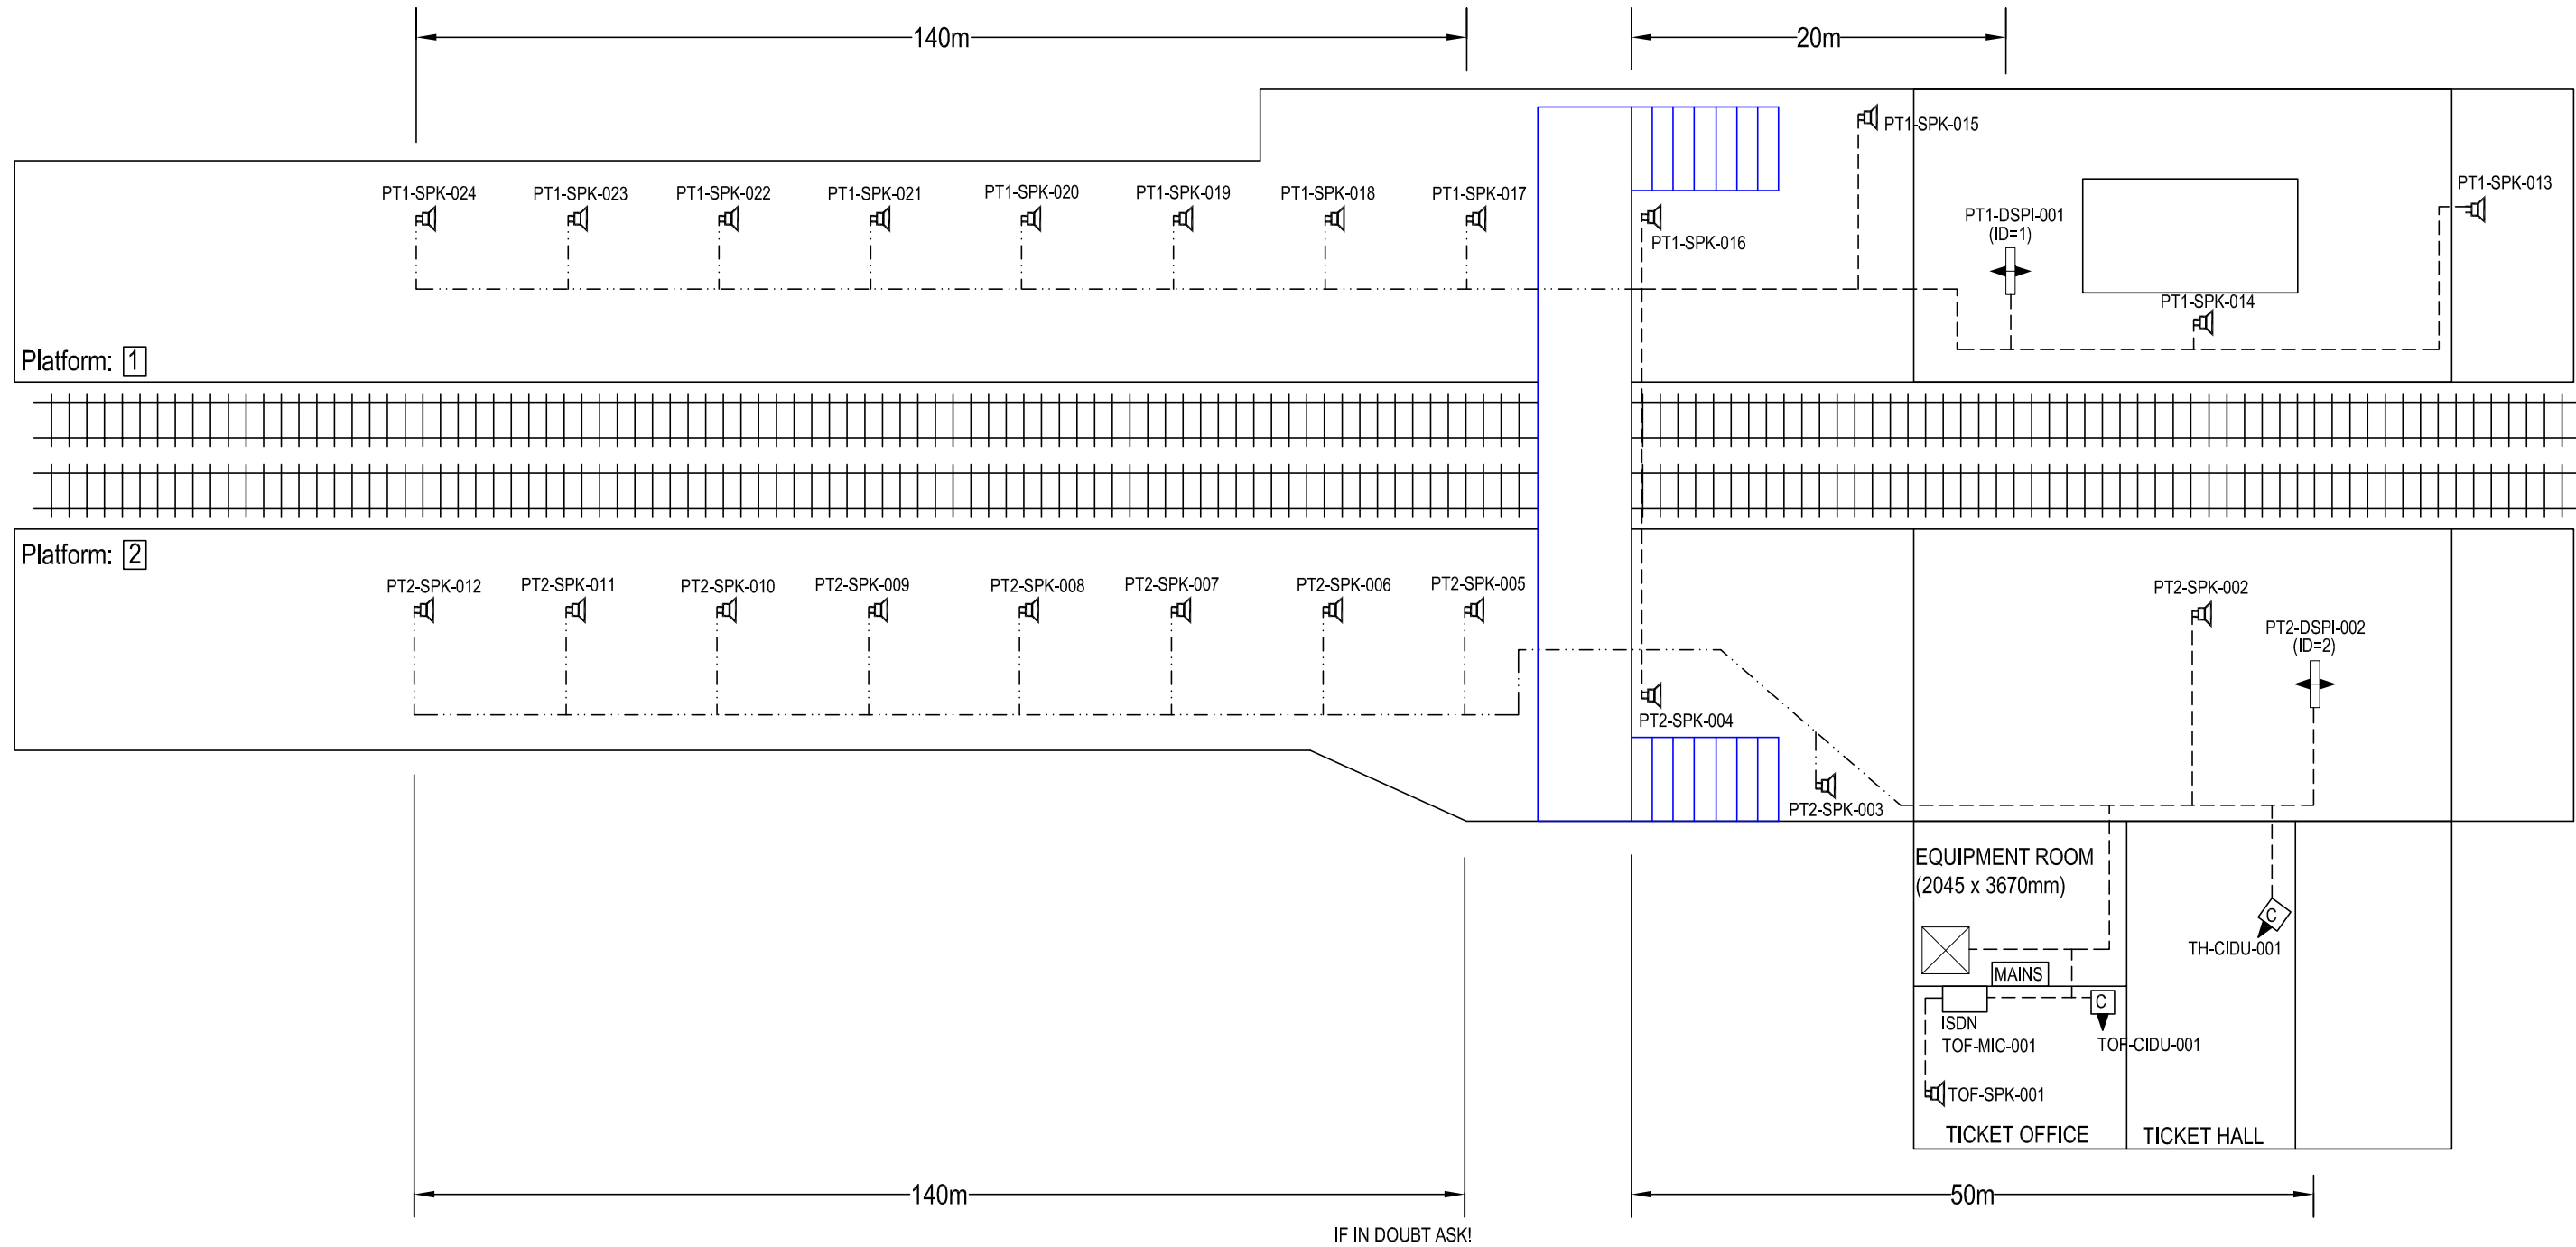

MATERIAL	
FINISH	

CONSTRUCTION		NAME	SIGNATURE	DATE
DRAWN BY		A HATTON		28-04-2002
CHECKED BY		T WONG		
APPD BY		A SMITH		
APPD BY				
CAD Ref:				
CONTRACTOR'S Ref:				



AMEY DATEL Project
 Offices
 1st Floor, Platform
 2/3
 Eastleigh Station
 Southampton Road
 Eastleigh
 Hants
 SO50 9FL

COPYRIGHT © AMEY Rail
 All rights reserved. Neither this drawing or any of the information it contains may be copied or communicated to third parties without the written permission of the copyright holder

SITE/PROJECT		SOUTH WEST TRAINS CIS PROJECT	
TITLE		WHITCHURCH AS BUILT	
SCALE	DRG No.	ISSUE	SHEET
NTS	SM803-75527	B	1 of 1