



WAN	
CIRCUIT ID	KXIP900447
IP ADDRESS	10.227.234.1

"PLATFORM 1 HP ISDN"
020-83350753
"PLATFORM 2 HP ISDN"
020-83553987

All Equipment tags to be prefixed with "WCP-"

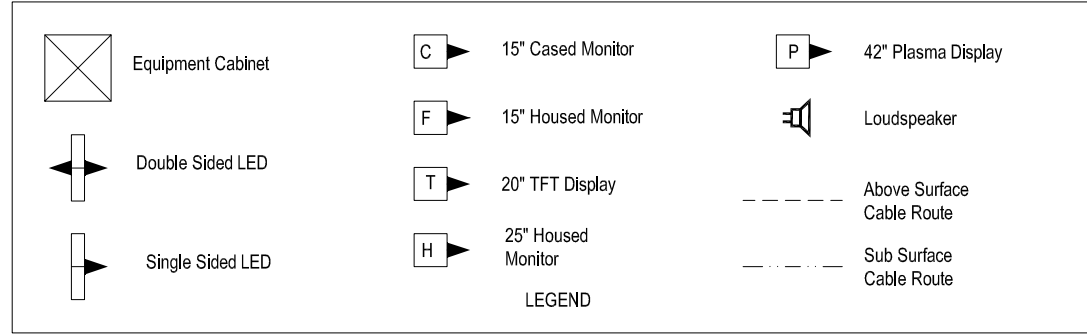

Equipment	Dist Board
	CRABTREE 6 WAY AT BACK OF T.O.
PT1-DSPI-001	CCT 3
PT2-DSPI-002	CCT 3
CIS RACK	CCT 4

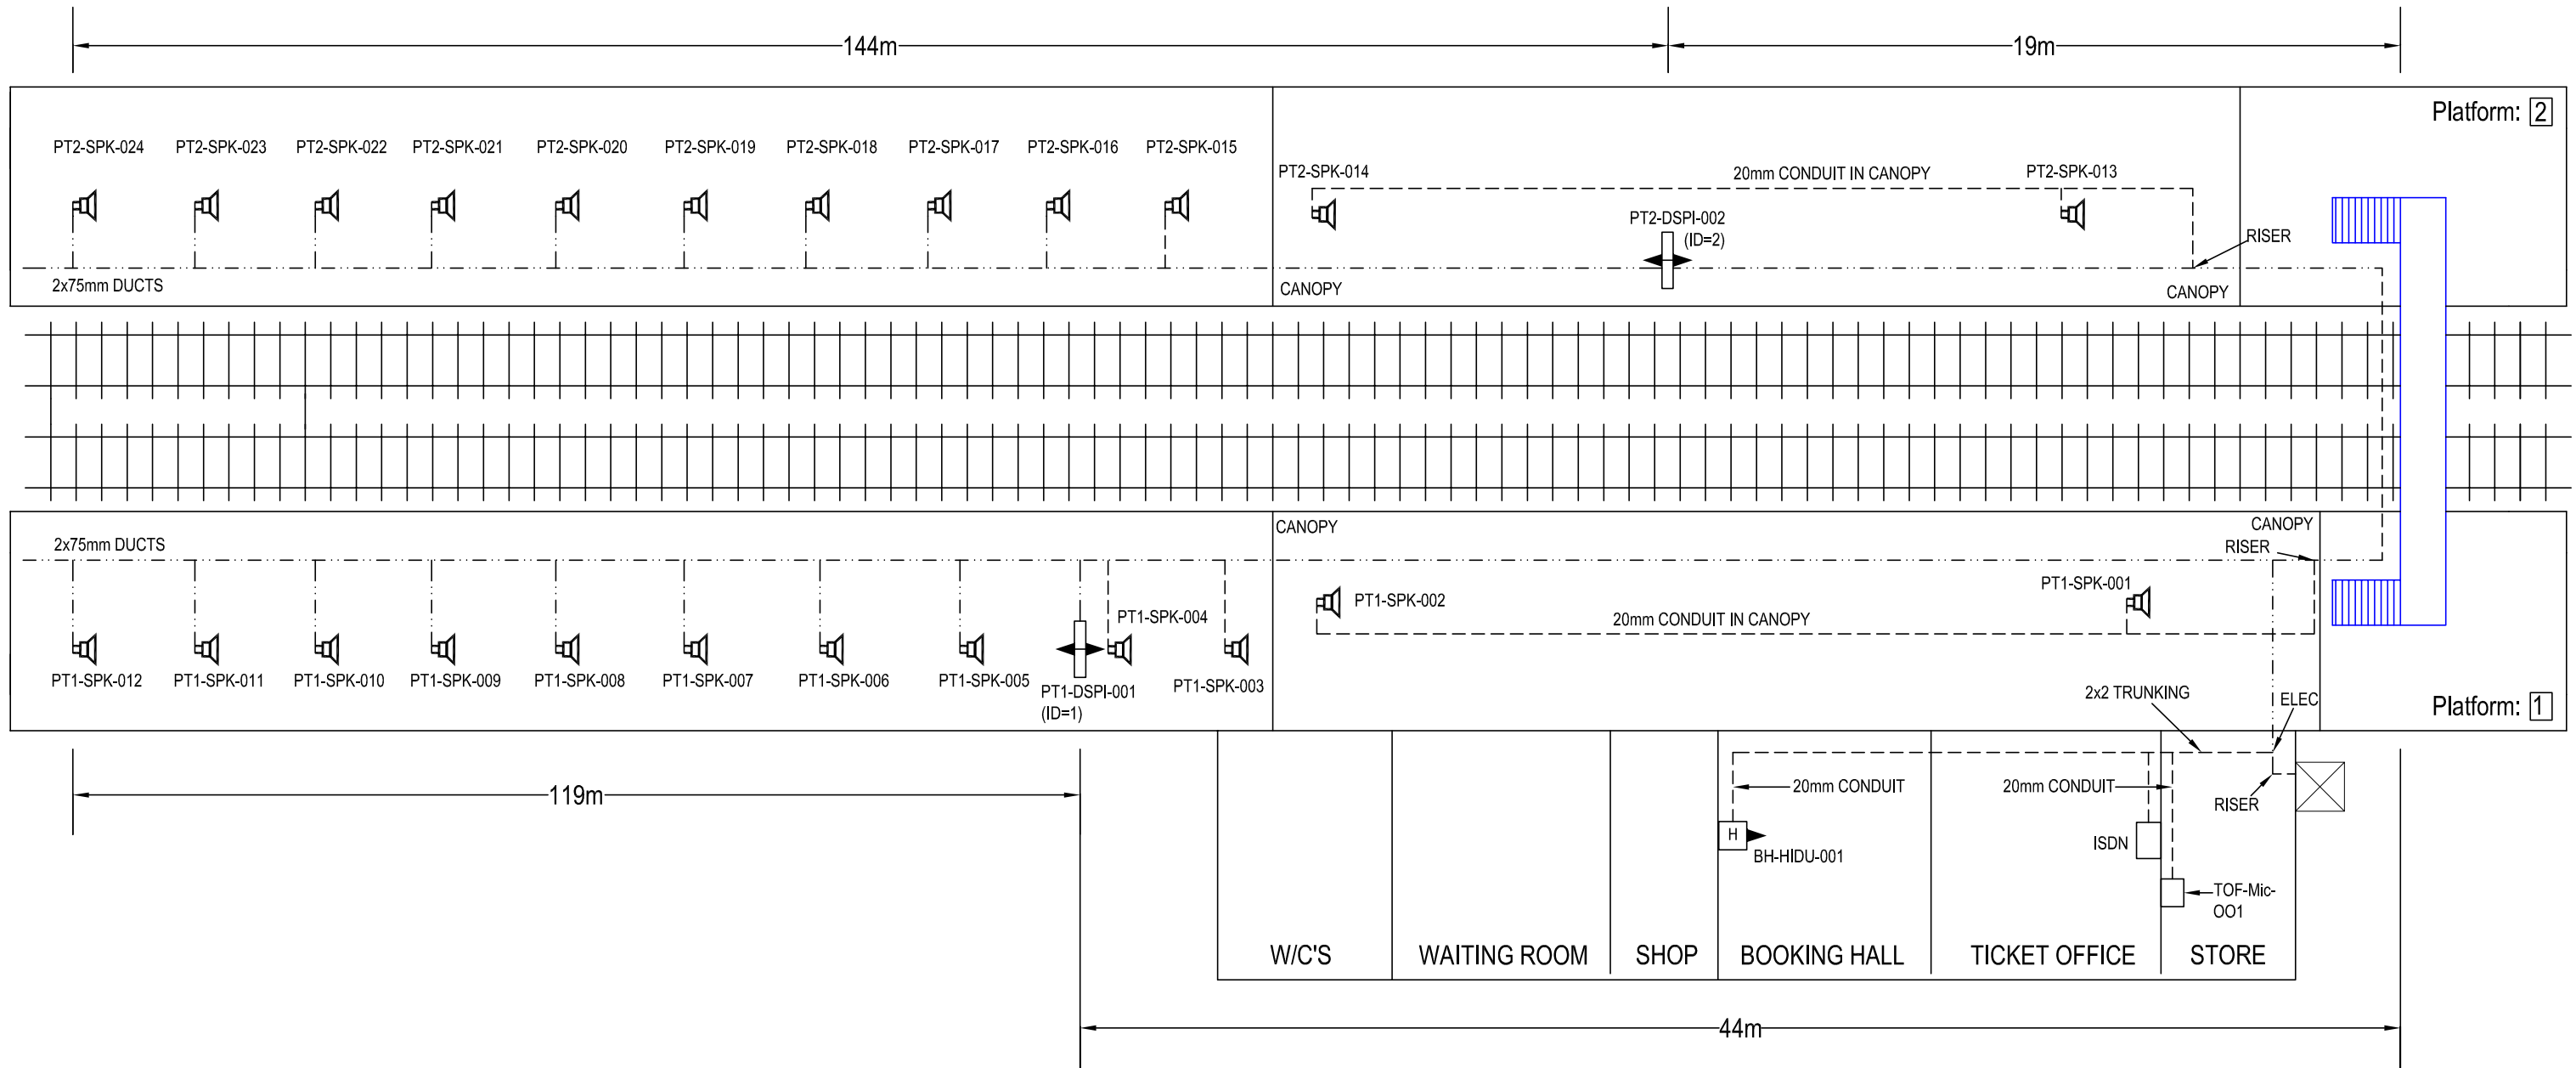

IF IN DOUBT ASK!

MATERIAL	CONSTRUCTION	<table border="1"> <thead> <tr> <th>NAME</th> <th>SIGNATURE</th> <th>DATE</th> </tr> </thead> <tbody> <tr> <td>DRAWN BY: D GADDU</td> <td></td> <td>14-05-2002</td> </tr> <tr> <td>CHECKED BY: T WONG</td> <td></td> <td></td> </tr> <tr> <td>APPD BY: A SMITH</td> <td></td> <td></td> </tr> <tr> <td>APPD BY:</td> <td></td> <td></td> </tr> </tbody> </table>	NAME	SIGNATURE	DATE	DRAWN BY: D GADDU		14-05-2002	CHECKED BY: T WONG			APPD BY: A SMITH			APPD BY:			<p>AMEY DATEL Project Offices 1st Floor, Platform 2/3 Eastleigh Station Southampton Road Eastleigh Hants SO50 9FL</p>	SITE/PROJECT SOUTH WEST TRAINS CIS PROJECT	
		NAME	SIGNATURE	DATE																
DRAWN BY: D GADDU		14-05-2002																		
CHECKED BY: T WONG																				
APPD BY: A SMITH																				
APPD BY:																				
FINISH			TITLE WORCESTER PARK AS BUILT																	
		CAD Ref:	<p>COPYRIGHT © AMEY Rail All rights reserved. Neither this drawing or any of the information it contains may be copied or communicated to third parties without the written permission of the copyright holder</p>	SCALE NTS	DRG No. SM803-75579															
		CONTRACTOR'S Ref:		ISSUE B	SHEET 1 of 1															