



WAN	
CIRCUIT ID	KXIP 300432
IP ADDRESS	10.227.73.1

"PLATFORM 1 HP ISDN"
01-305-761991

All Equipment tags to be prefixed with "WEY-"

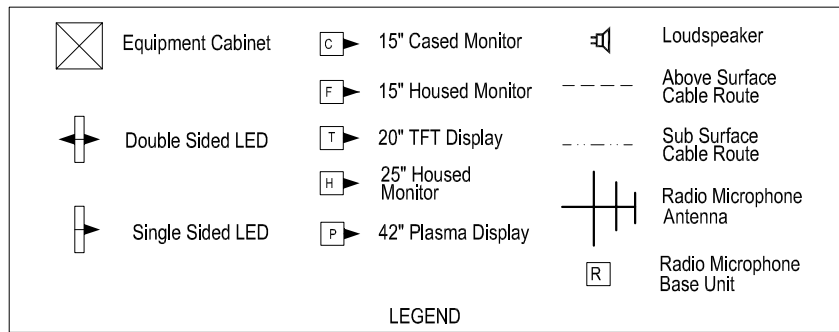

Equipment	Dist Board
CCT BK 1	CIS
BK 2	13A TWIN
BK 3	CRT T/HALL
BK 4	CRT T/OFFICE
BK 5	CRT CANTEEN
BK 6	CRT SUPER OFFICE

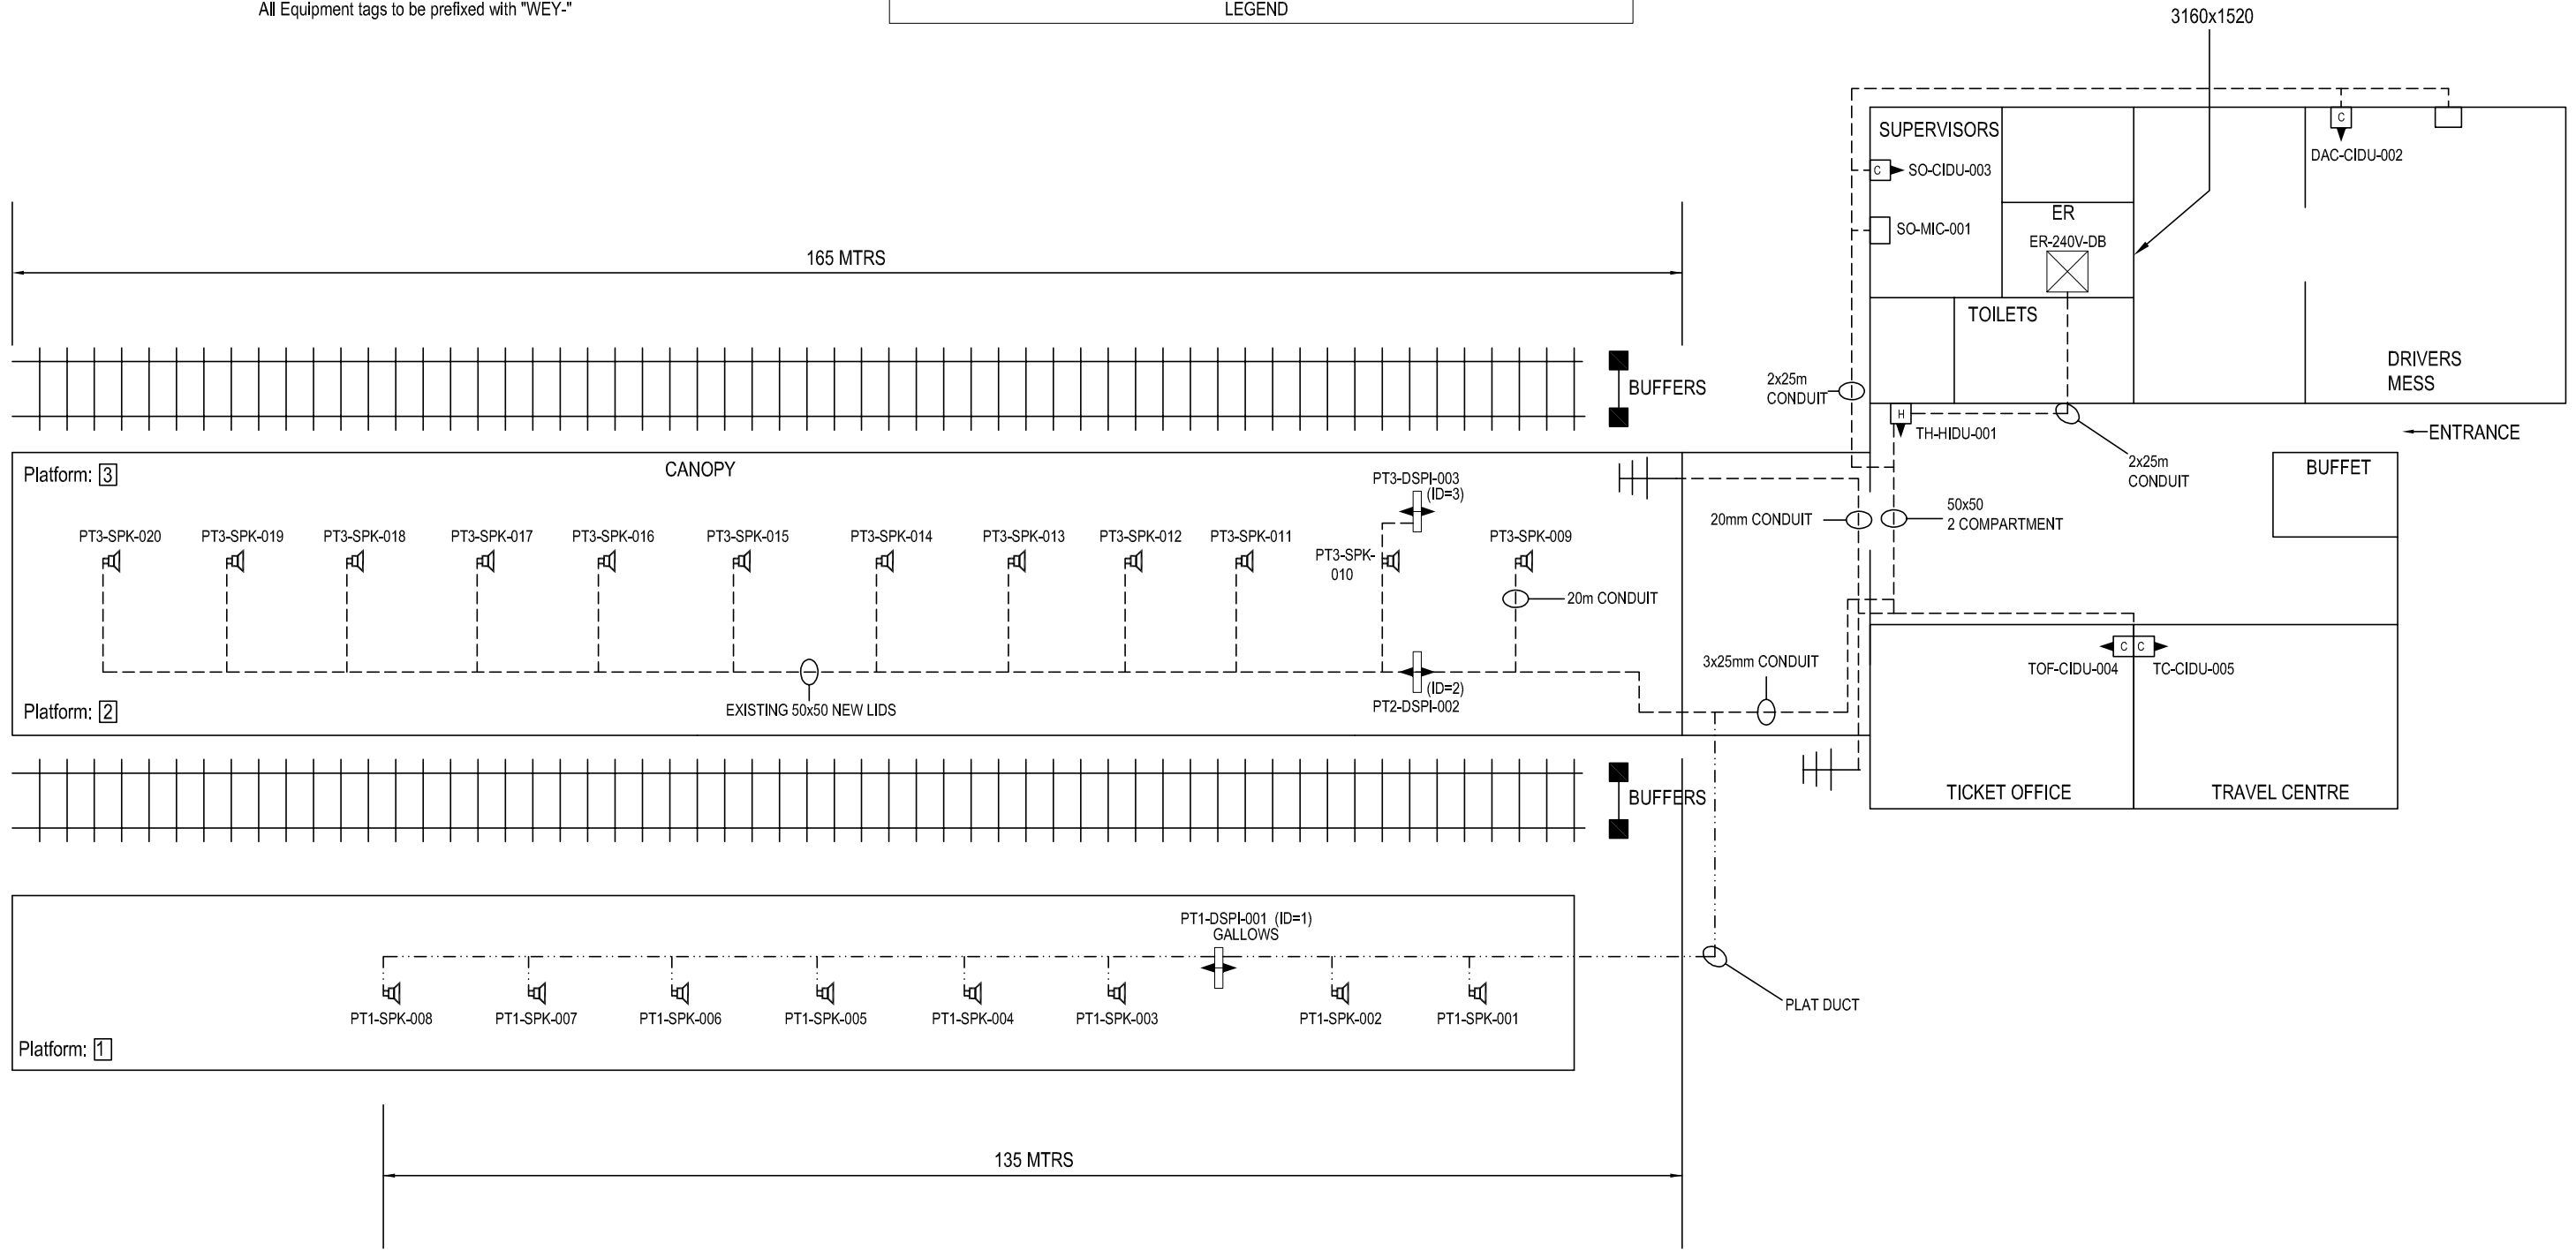

IF IN DOUBT ASK!

MATERIAL	CONSTRUCTION	NAME	SIGNATURE	DATE	<p>AMEY DATEL Project Offices 1st Floor, Platform 2/3 Eastleigh Station Southampton Road Eastleigh Hants SO50 9FL</p>	SITE/PROJECT			
		DRAWN BY: D GADDU				SOUTH WEST TRAINS CIS PROJECT			
FINISH		CHECKED BY: T WONG			<p>COPYRIGHT © AMEY Rail All rights reserved. Neither this drawing or any of the information it contains may be copied or communicated to third parties without the written permission of the copyright holder</p>	TITLE			
		APPD BY:				WEYMOUTH AS BUILT			
		CAD Ref:				SCALE: NTS	DRG No. SM803-75965	ISSUE: B	SHEET: 1 of 1
		CONTRACTOR'S Ref:							