





WAN	
CIRCUIT ID	KXIP 300 433
IP ADDRESS	10.227.225.1

"PLATFORM 1 HP ISDN"
01404-822058


All Equipment tags to be prefixed with "WHM-"

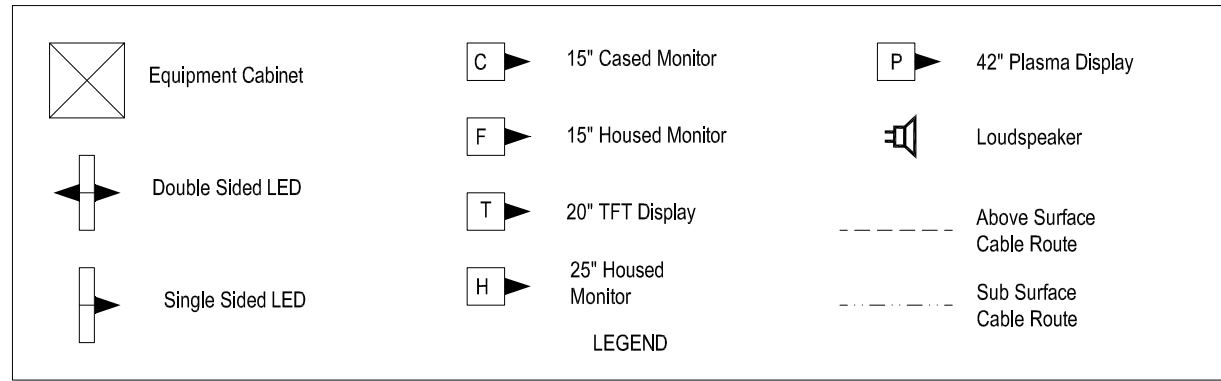

Equipment	Dist Board
CIS RACK	CCT NO. 1
LED PT1	CCT NO. 2
REMAINDER SPARE	

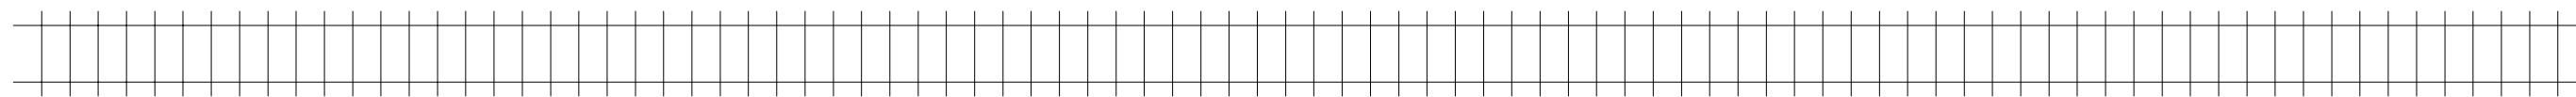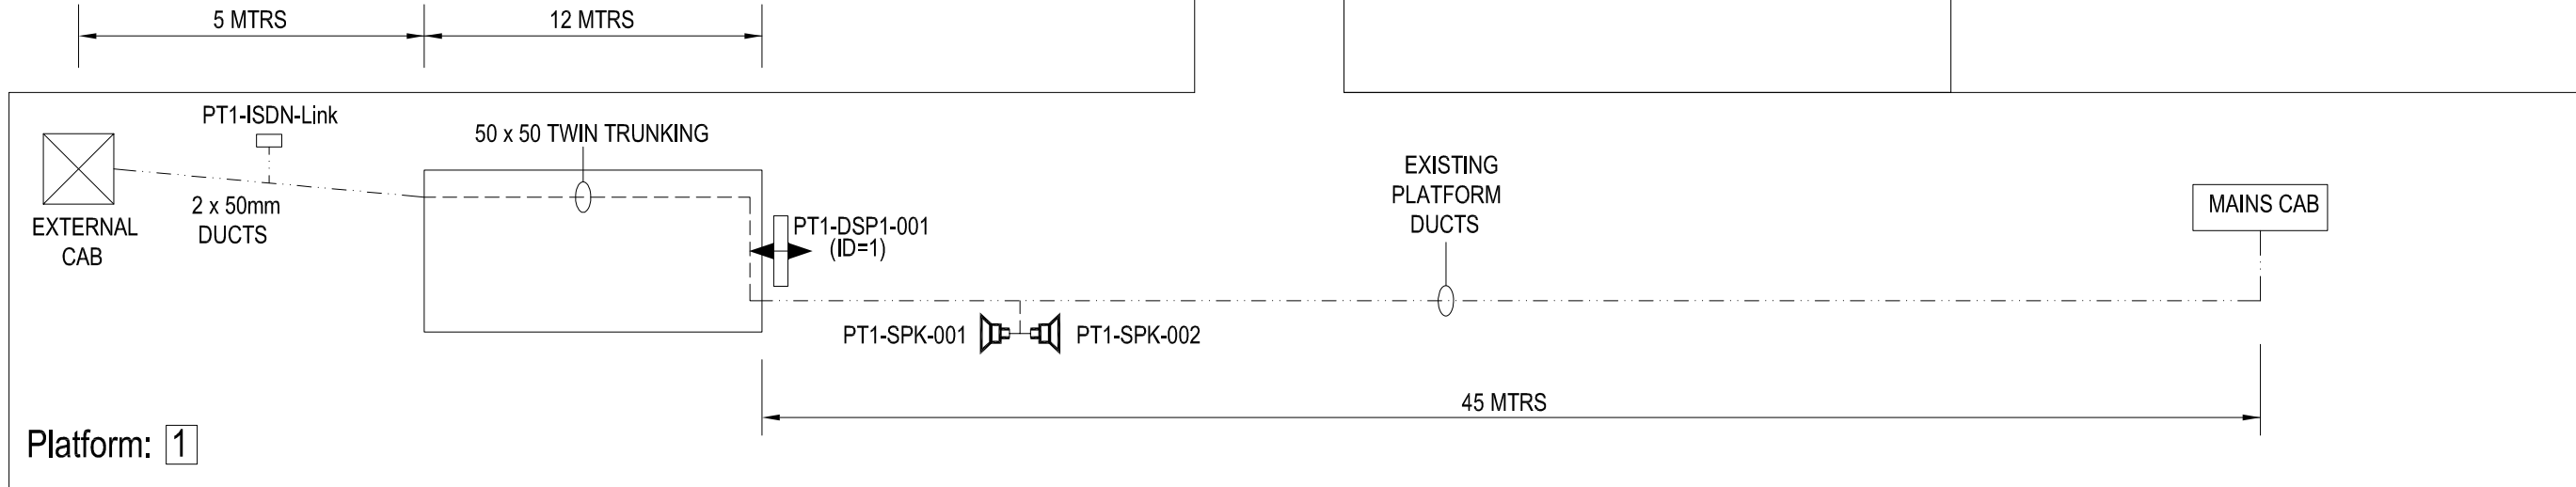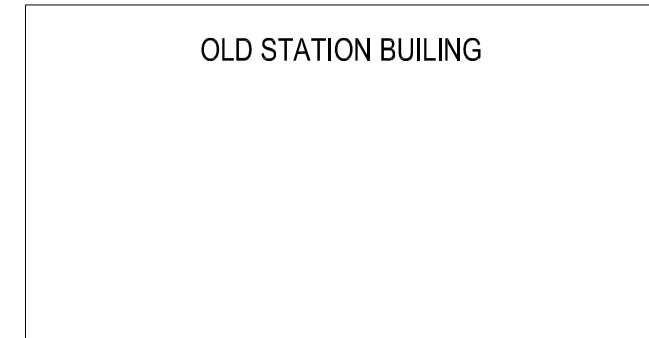

IF IN DOUBT ASK!

MATERIAL	CONSTRUCTION	<table border="1"> <thead> <tr> <th></th> <th>NAME</th> <th>SIGNATURE</th> <th>DATE</th> </tr> </thead> <tbody> <tr> <td>DRAWN BY</td> <td>D GADDU</td> <td></td> <td>15-03-2002</td> </tr> <tr> <td>CHECKED BY</td> <td>T WONG</td> <td></td> <td></td> </tr> <tr> <td>APPD BY</td> <td></td> <td></td> <td></td> </tr> <tr> <td>APPD BY</td> <td></td> <td></td> <td></td> </tr> </tbody> </table>				NAME	SIGNATURE	DATE	DRAWN BY	D GADDU		15-03-2002	CHECKED BY	T WONG			APPD BY				APPD BY				 <p>AMEY DATEL Project Offices 1st Floor, Platform 2/3 Eastleigh Station Southampton Road Eastleigh Hants SO50 9FL</p>		SITE/PROJECT	
			NAME	SIGNATURE	DATE																							
DRAWN BY	D GADDU		15-03-2002																									
CHECKED BY	T WONG																											
APPD BY																												
APPD BY																												
FINISH		SOUTH WEST TRAINS CIS PROJECT																										
				TITLE		WHIMPLE AS BUILT																						
				SCALE	DRG No.	ISSUE	SHEET																					
				NTS	SM803-75759	B	1 of 1																					
				COPYRIGHT © AMEY Rail All rights reserved. Neither this drawing or any of the information it contains may be copied or communicated to third parties without the written permission of the copyright holder																								