



WAN	
CIRCUIT ID	KXIP700561
IP ADDRESS	10.227.238.1

All Equipment tags to be prefixed with "WIM-"

"PLATFORM 1 HP ISDN"	0208-946-0221
"PLATFORM 5 HP ISDN"	0208-946-0434
"PLATFORM 7 HP ISDN"	0208-946-0789
"PLATFORM 5 HP ISDN"	0208-946-0810

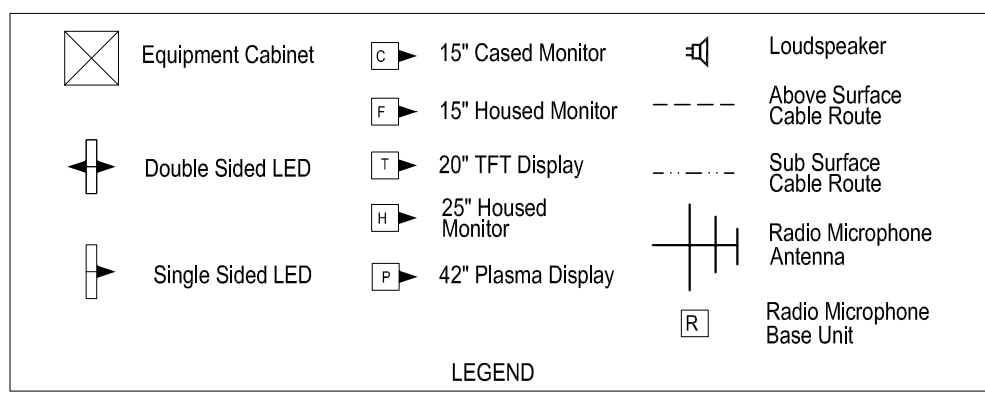

Equipment	Dist Board	
EXISTING SUPPLIES USED		

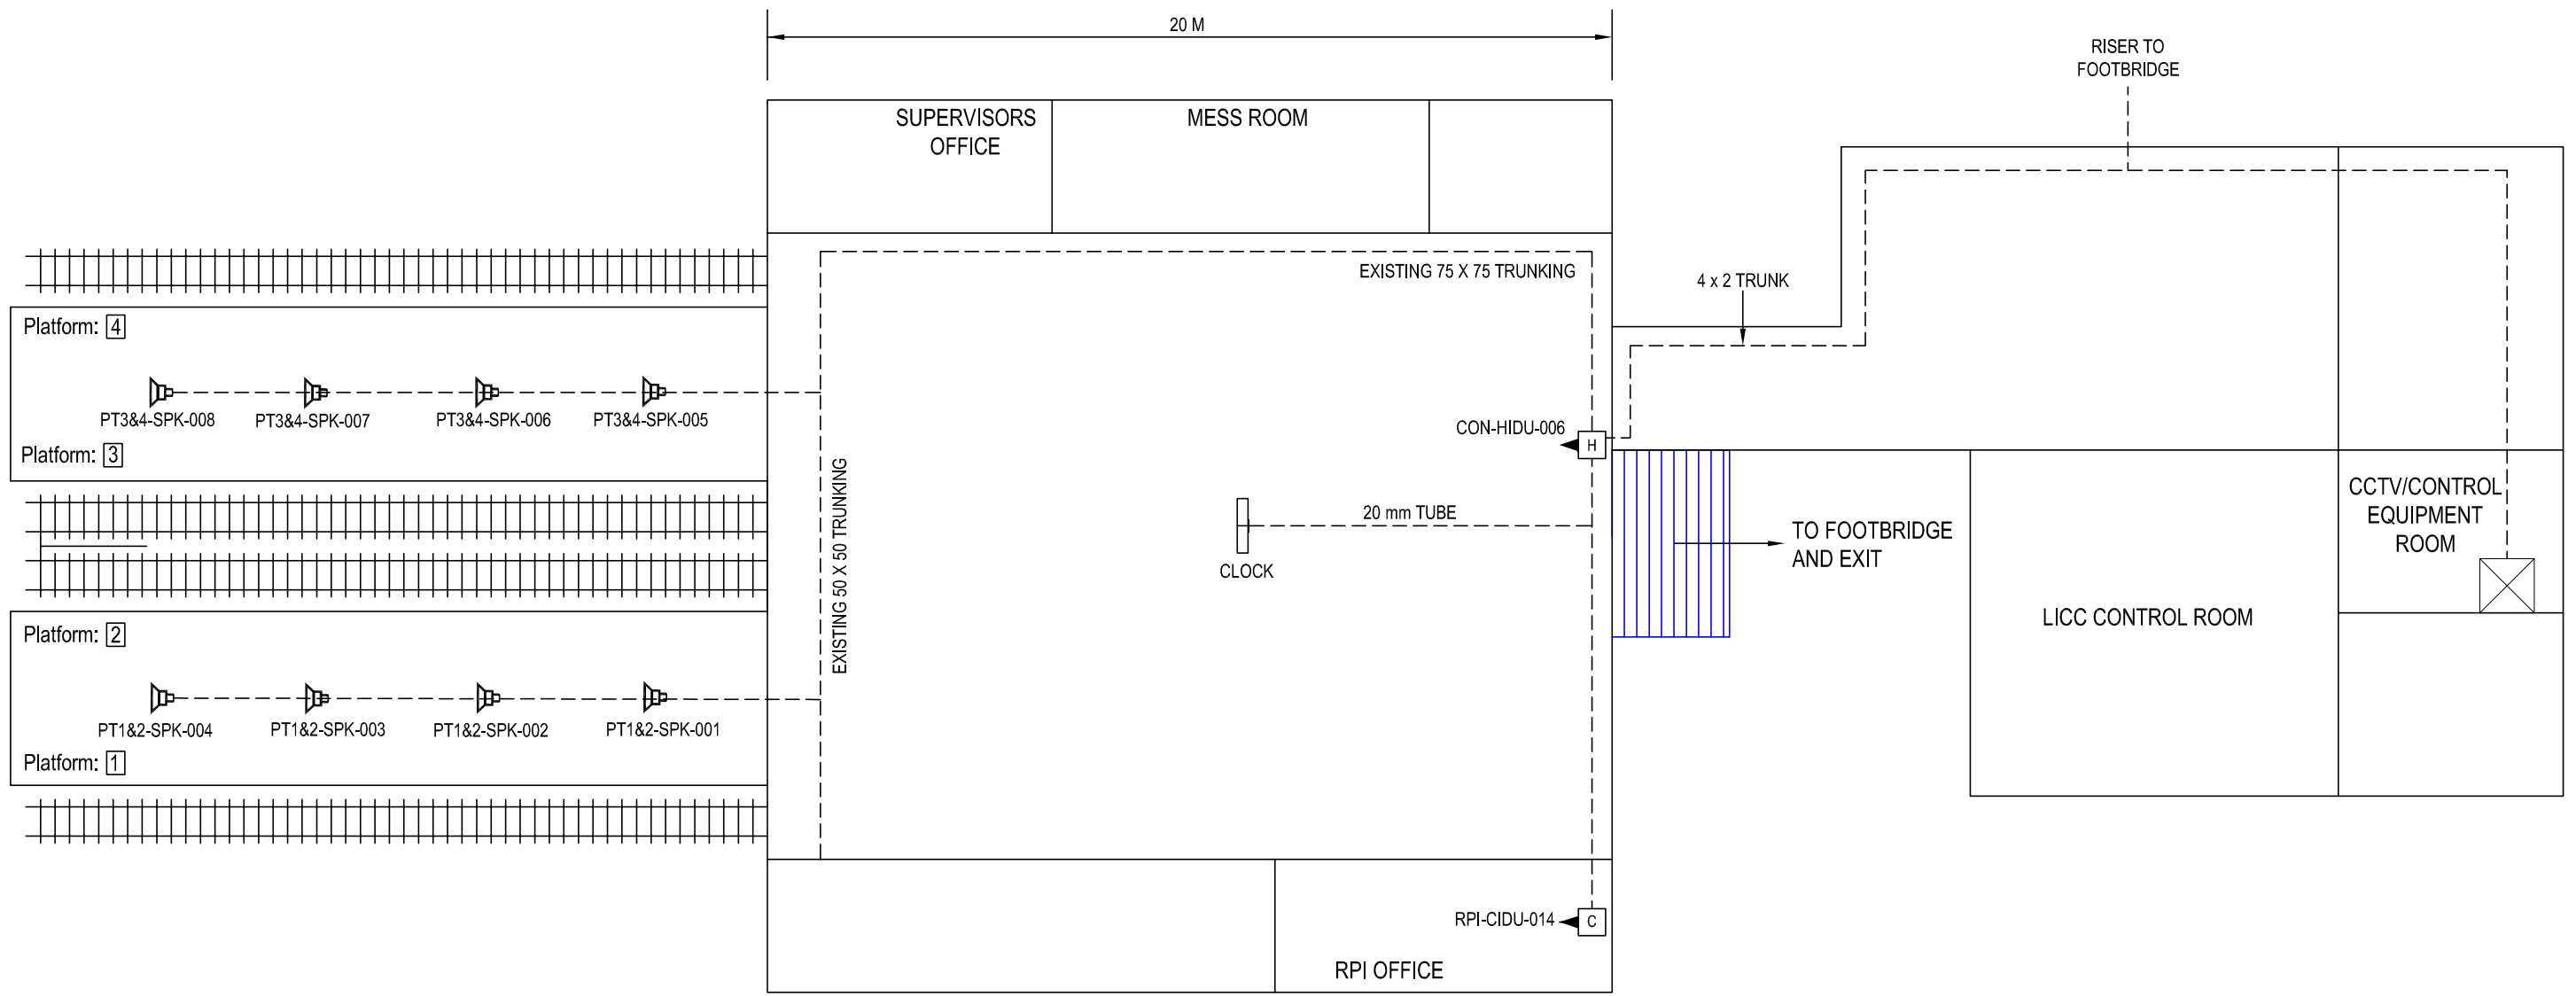

IF IN DOUBT ASK!

Date of Last Modification: 25 April 2003
 This Drawing Supersedes Any Previous Drawings

CONSTRUCTION	CONSTRUCTION	NAME	SIGNATURE	DATE
		J STEVENS		24-04-2003
		T WONG		
		A SMITH		
FINISH		CAD Ref:		
		CONTRACTOR'S Ref:		



AMEY DATEL Project Offices
 1st Floor, Platform 2/3
 Eastleigh Station
 Southampton Road
 Eastleigh
 Hants
 SO50 9FL


COPYRIGHT © AMEY Rail
 All rights reserved. Neither this drawing or any of the information it contains may be copied or communicated to third parties without the written permission of the copyright holder

SITE/PROJECT		SOUTH WEST TRAINS CIS PROJECT	
TITLE		WIMBLEDON LUL BOOKING HALL & CONTROL ROOM AS BUILT	
SCALE	DRG No.	ISSUE	SHEET
NTS	SM803-75578	C	1 of 5


WAN	
CIRCUIT ID	KXIP700561
IP ADDRESS	10.227.238.1

All Equipment tags to be prefixed with "WIM-"

"PLATFORM 1 HP ISDN"	0208-946-0221
"PLATFORM 5 HP ISDN"	0208-946-0434
"PLATFORM 7 HP ISDN"	0208-946-0789
"PLATFORM 5 HP ISDN"	0208-946-0810

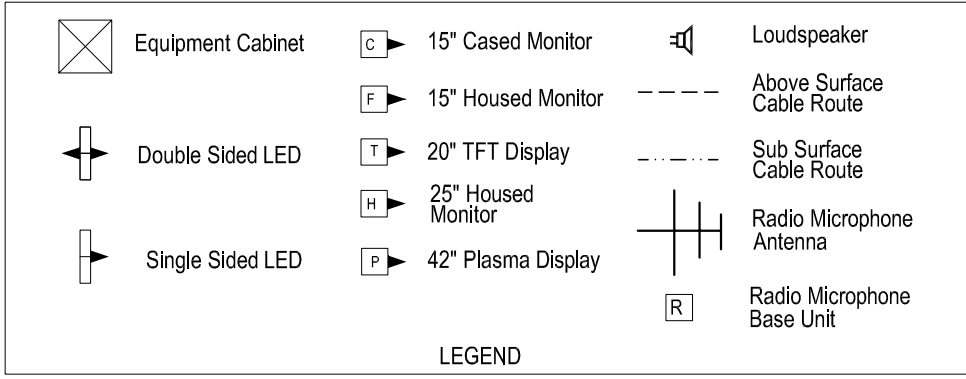

Equipment	Dist Board	
EXISTING SUPPLIES USED		

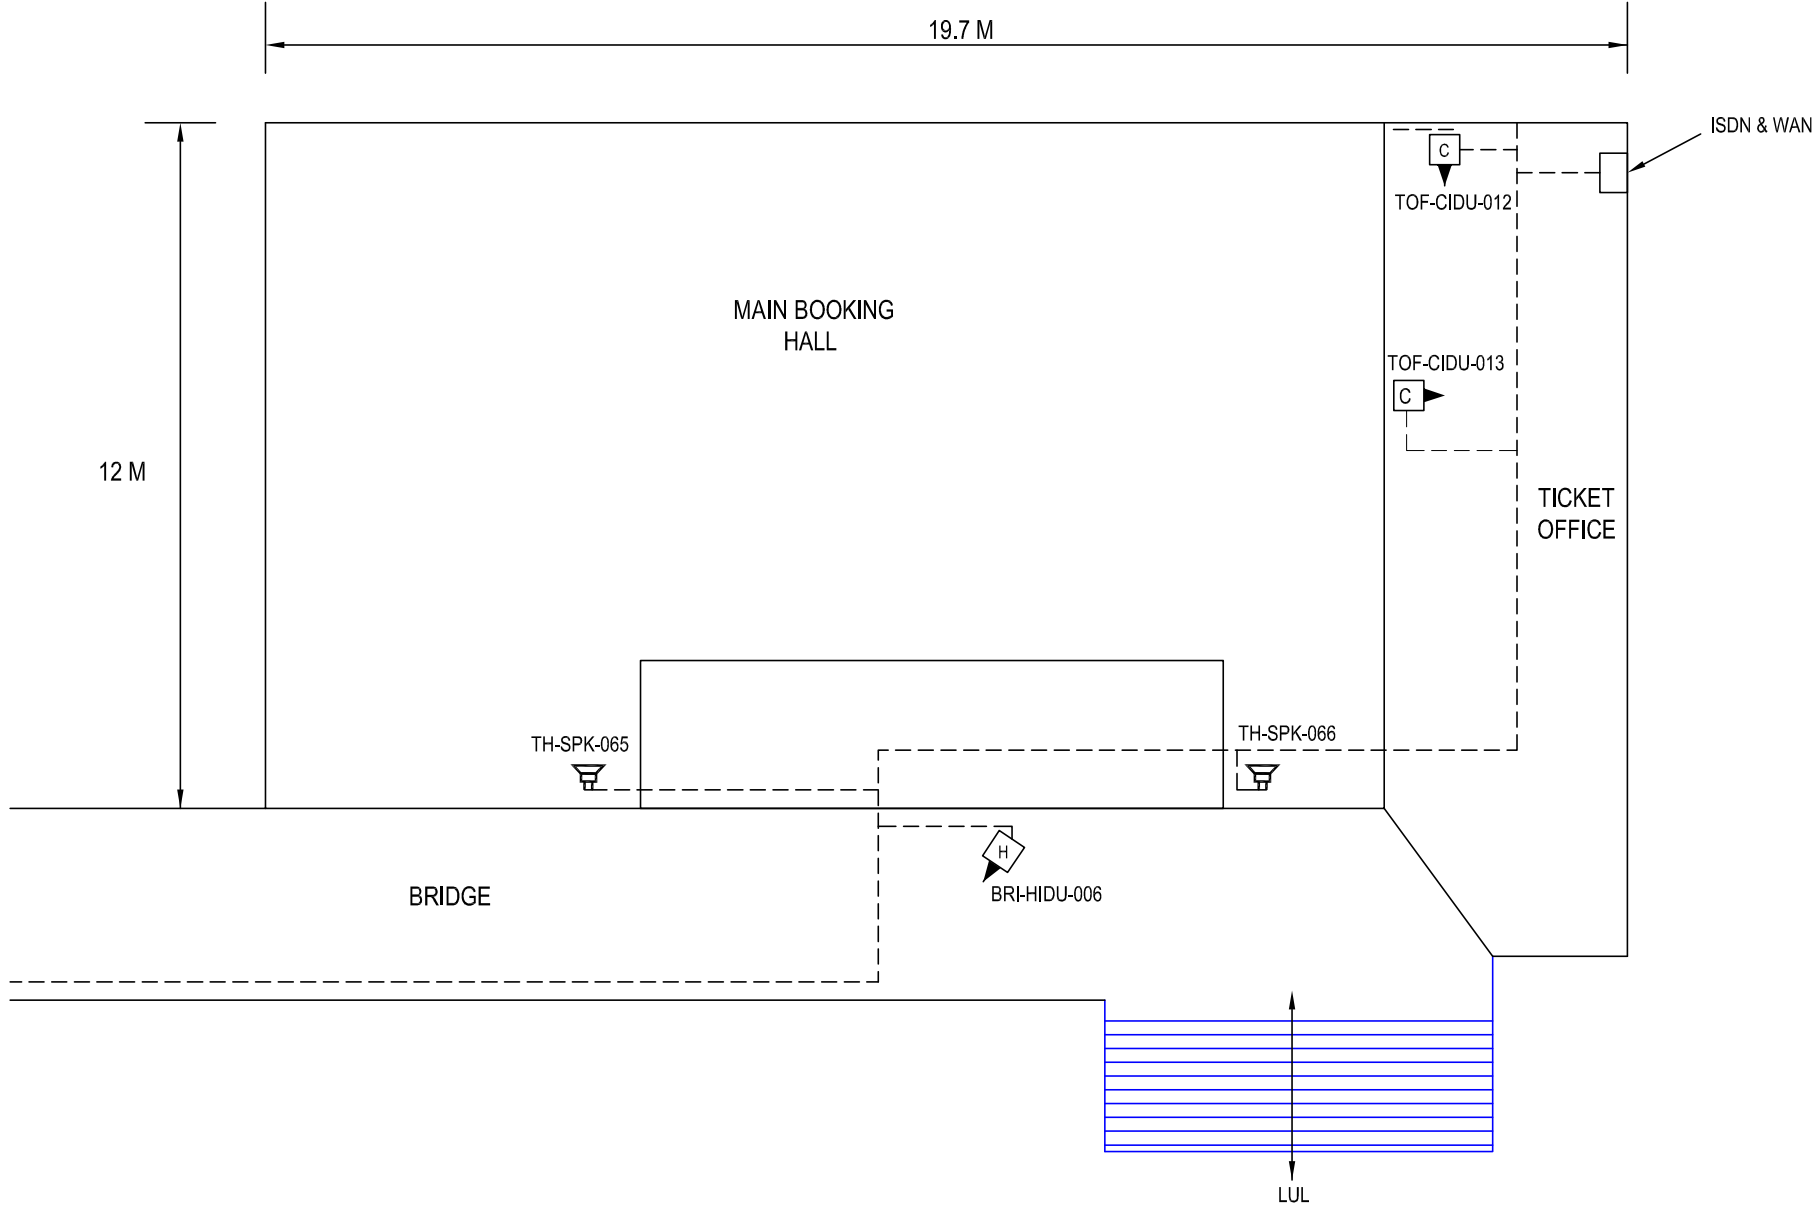

IF IN DOUBT ASK!

Date of Last Modification: 25 April 2003

This Drawing Supersedes Any Previous Drawings

CONSTRUCTION	NAME	SIGNATURE	DATE
DRAWN BY	J STEVENS		25-04-2003
CHECKED BY	T WONG		
APPD BY	A SMITH		
APPD BY			
CAD Ref:			
CONTRACTOR'S Ref:			

AMEY DATEL Project
 Offices
 1st Floor, Platform
 2/3
 Eastleigh Station
 Southampton Road
 Eastleigh
 Hants
 SO50 9FL


COPYRIGHT © AMEY Rail
 All rights reserved. Neither this drawing or any of the information it contains may be copied or communicated to third parties without the written permission of the copyright holder

SITE/PROJECT		SOUTH WEST TRAINS CIS PROJECT	
TITLE		WIMBLEDON BOOKING HALL AS BUILT	
SCALE	DRG No.	ISSUE	SHEET
NTS	SM803-75578	C	2 of 5


WAN	
CIRCUIT ID	KXIP700561
IP ADDRESS	10.227.238.1

All Equipment tags to be prefixed with "WIM-"

"PLATFORM 1 HP ISDN"
0208-946-0221
"PLATFORM 5 HP ISDN"
0208-946-0434
"PLATFORM 7 HP ISDN"
0208-946-0789
"PLATFORM 5 HP ISDN"
0208-946-0810

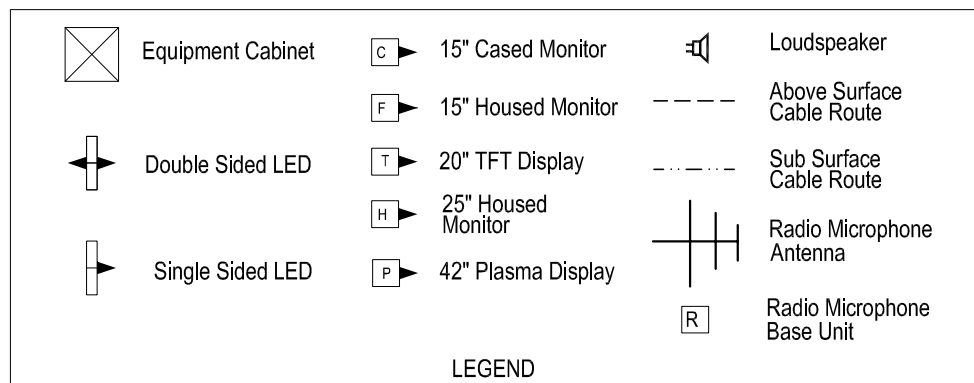

Equipment	Dist Board	
RADIO MIC BASE	PT5/6 GP1	R3
PT5-DSPI-008	PT5/6 GP2	R1
PT5-DSPI-009	PT5/6 GP2	R1
FB-HIDU-005	FB GP1	
PT5-HIDU-003	FB GP1	

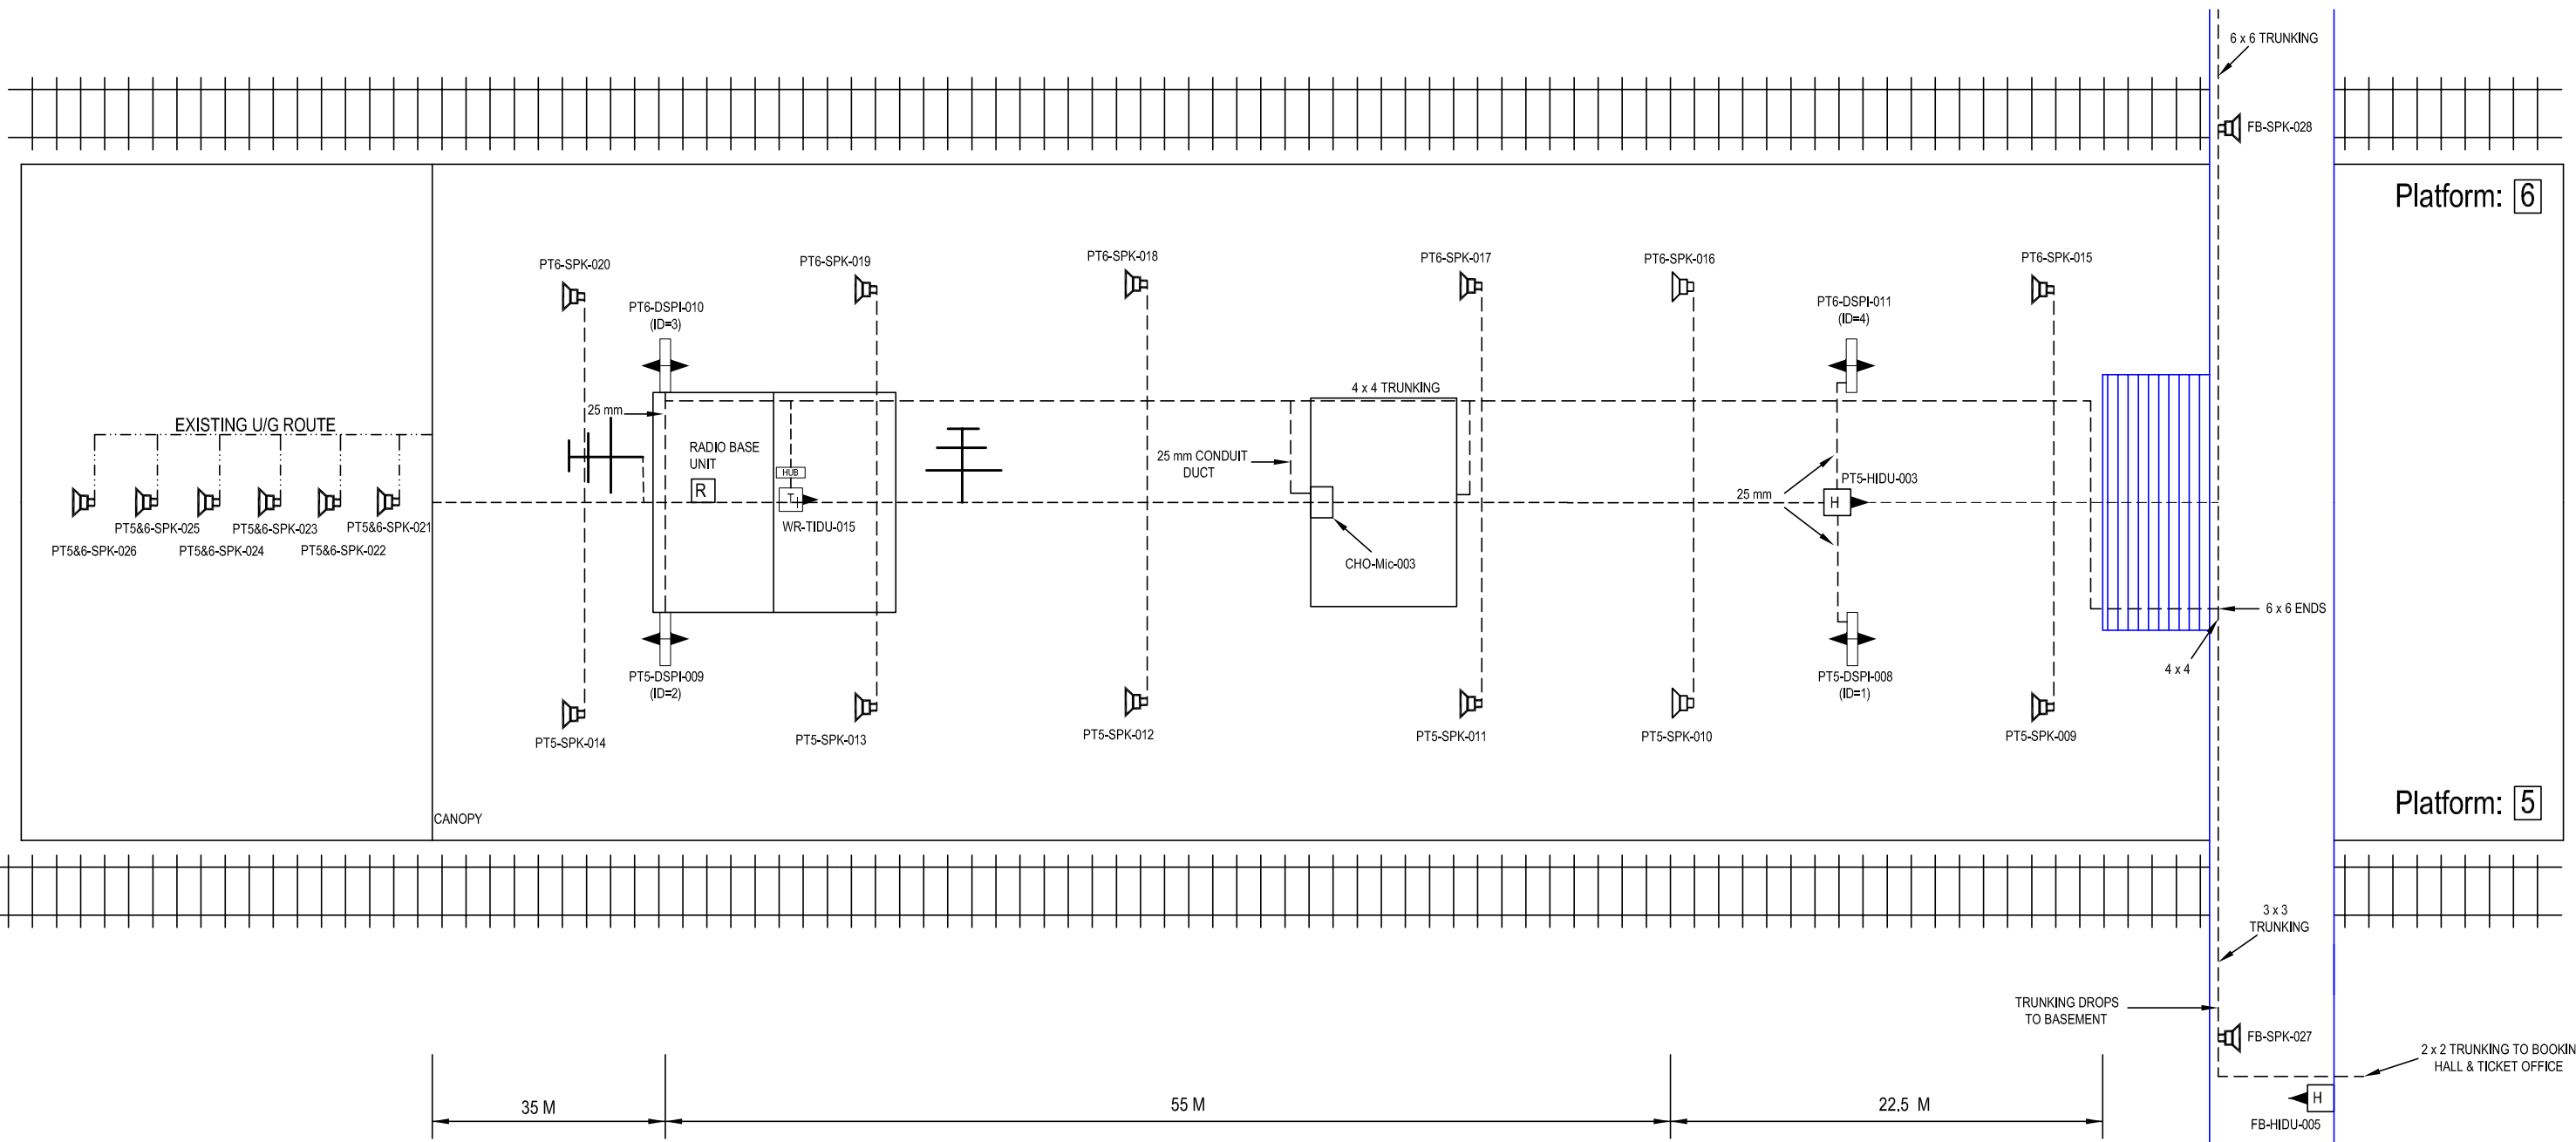

IF IN DOUBT ASK!

Date of Last Modification: 25 April 2003

This Drawing Supersedes Any Previous Drawings

CONSTRUCTION

	NAME	SIGNATURE	DATE
DRAWN BY	J STEVENS		25-04-2003
CHECKED BY	T WONG		
APPD BY	A SMITH		
APPD BY			
CAD Ref:			
CONTRACTOR'S Ref:			



AMEY DATEL Project Offices
1st Floor, Platform 2/3
Eastleigh Station
Southampton Road
Eastleigh
Hants
SO50 9FL

SITE/PROJECT

SOUTH WEST TRAINS CIS PROJECT

TITLE

WIMBLEDON
PLATFORMS 5 & 6
AS BUILT

SCALE

NTS

DRG No.

SM803-75578

ISSUE

D


SHEET

3 of 5


WAN	
CIRCUIT ID	KXIP700561
IP ADDRESS	10.227.238.1

All Equipment tags to be prefixed with "WIM-"

"PLATFORM 1 HP ISDN"
0208-946-0221
"PLATFORM 5 HP ISDN"
0208-946-0434
"PLATFORM 7 HP ISDN"
0208-946-0789
"PLATFORM 5 HP ISDN"
0208-946-0810

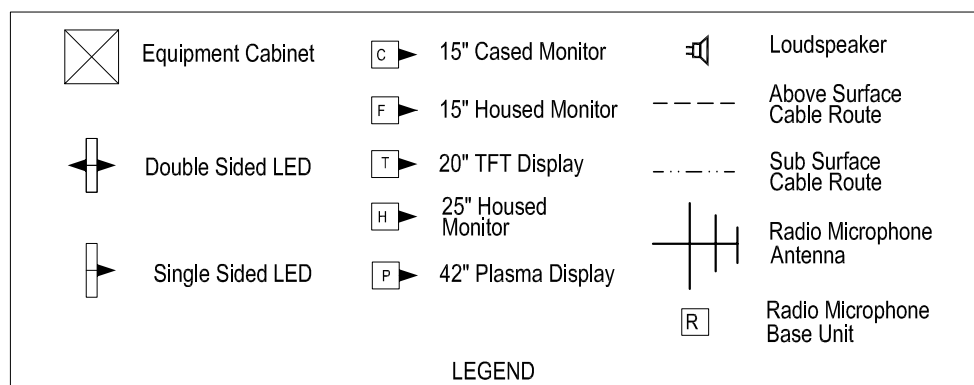

Equipment	Dist Board	
PT7-DSPI-005	GP 2	R1
PT8-DSPI-006	GP 2	R1

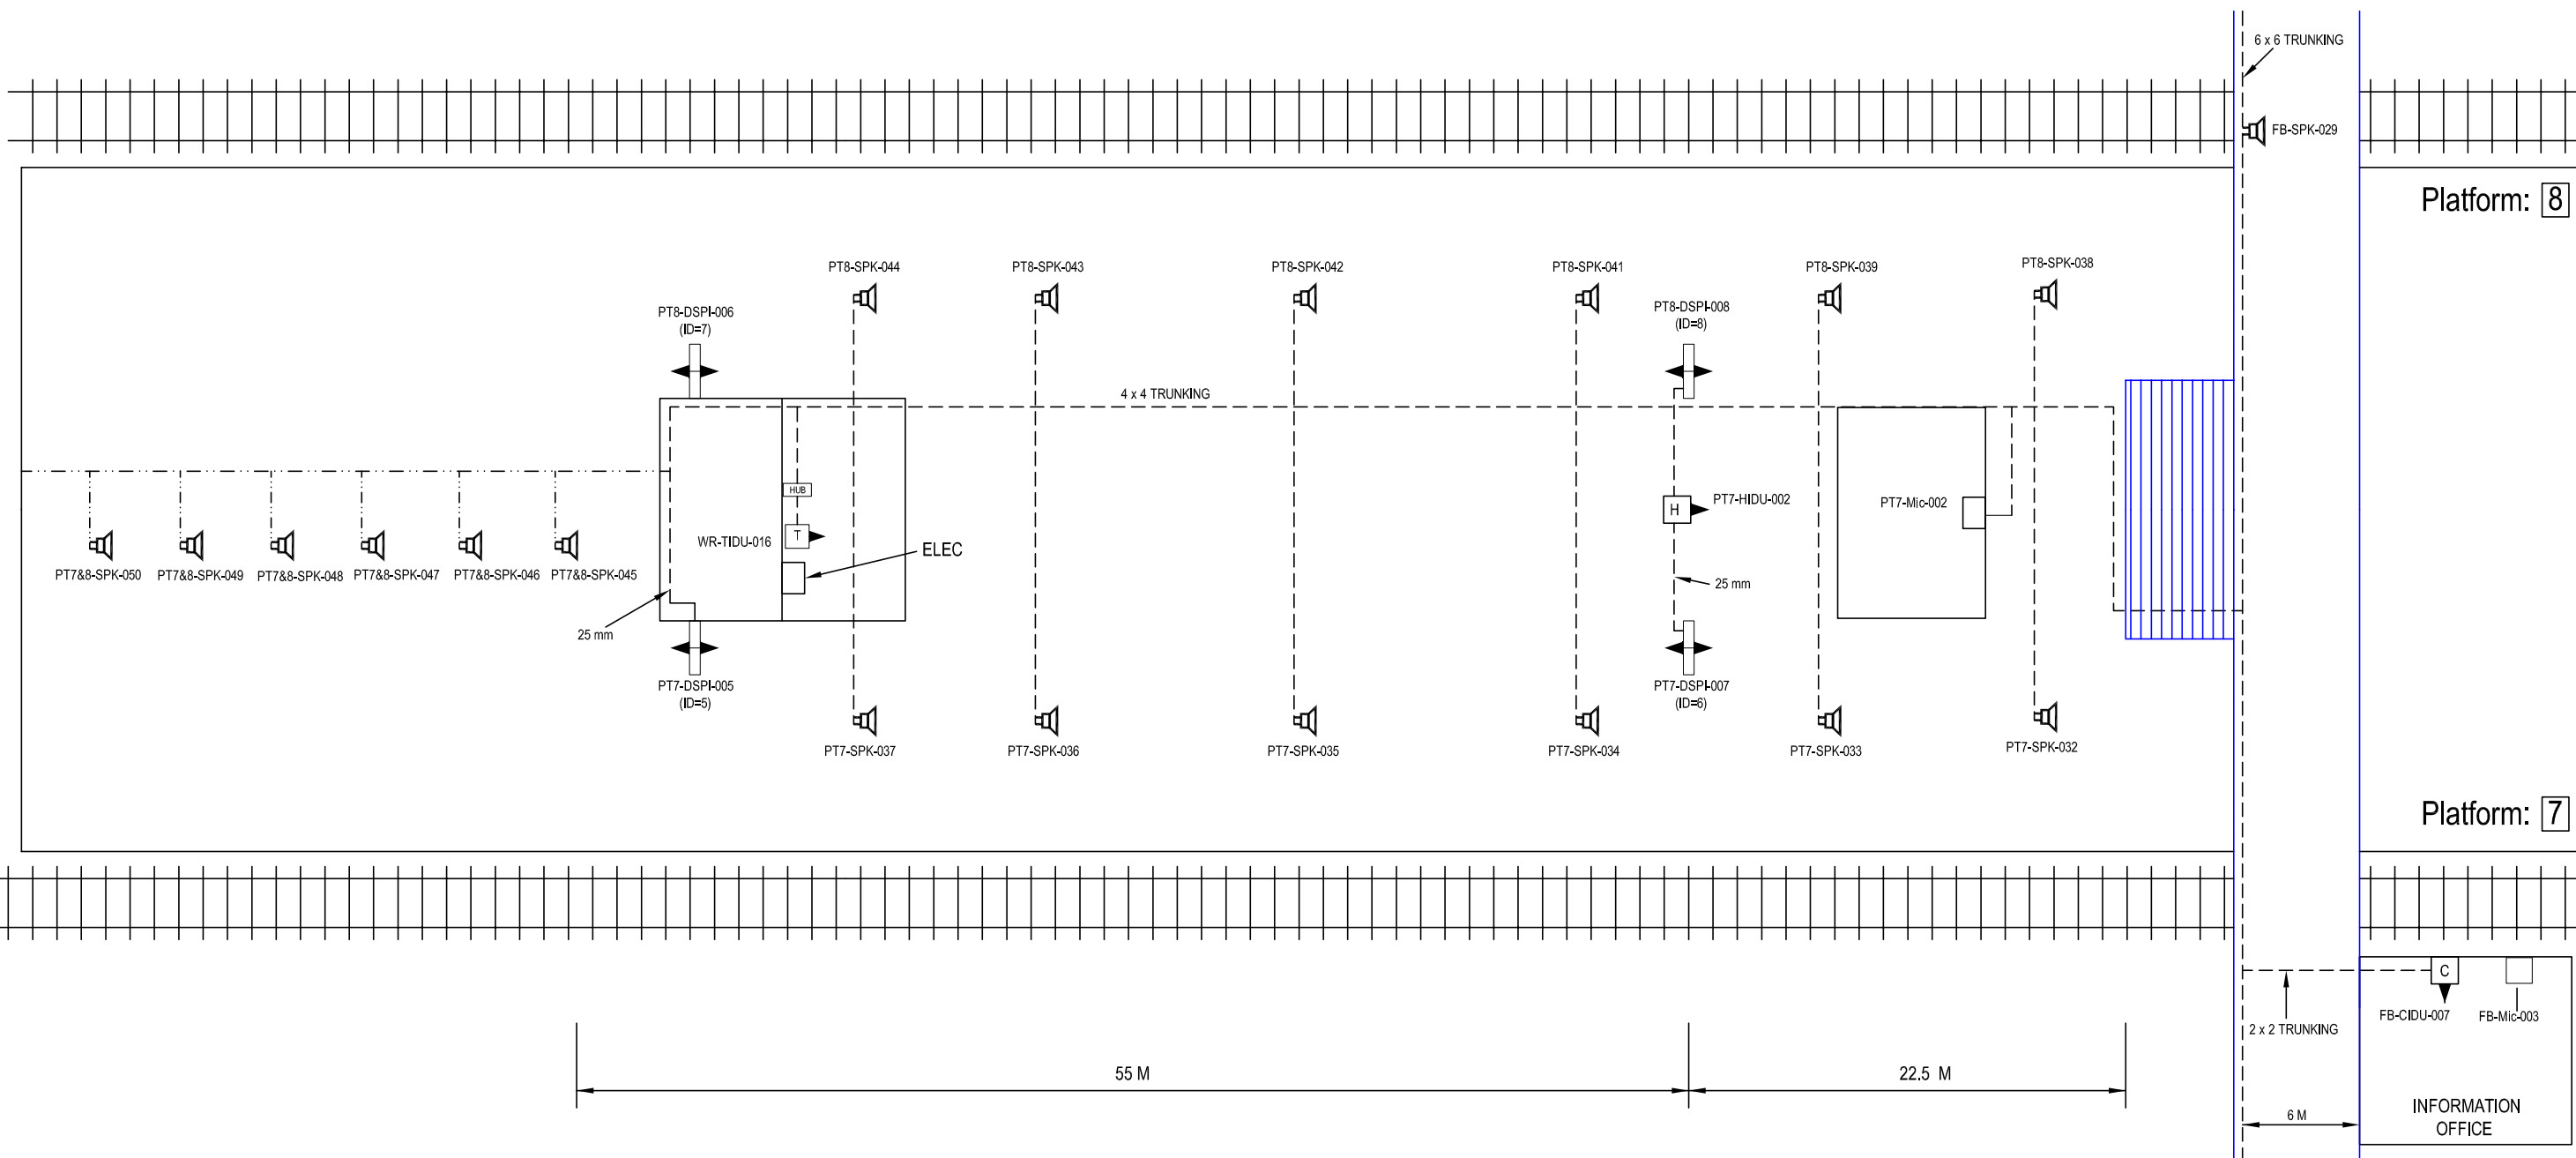

IF IN DOUBT ASK!

Date of Last Modification: 25 April 2003

CONSTRUCTION

	NAME	SIGNATURE	DATE
DRAWN BY	J STEVENS		25-04-2003
CHECKED BY	T WONG		
APPD BY	A SMITH		
APPD BY			
CAD Ref:			
CONTRACTOR'S Ref:			

This Drawing Supersedes Any Previous Drawings



AMEY DATEL Project Offices
1st Floor, Platform 2/3
Eastleigh Station
Southampton Road
Eastleigh
Hants
SO50 9FL

SITE/PROJECT SOUTH WEST TRAINS CIS PROJECT

TITLE WIMBLEDON PLATFORMS 7 & 8 AS BUILT

FINISH


COPYRIGHT © AMEY Rail
All rights reserved. Neither this drawing or any of the information it contains may be copied or communicated to third parties without the written permission of the copyright holder

SCALE	DRG No.	ISSUE	SHEET
NTS	SM803-75578	D	4 of 5


WAN	
CIRCUIT ID	KXIP700561
IP ADDRESS	10.227.238.1

All Equipment tags to be prefixed with "WIM-"

"PLATFORM 1 HP ISDN"
0208-946-0221
"PLATFORM 5 HP ISDN"
0208-946-0434
"PLATFORM 7 HP ISDN"
0208-946-0789
"PLATFORM 5 HP ISDN"
0208-946-0810

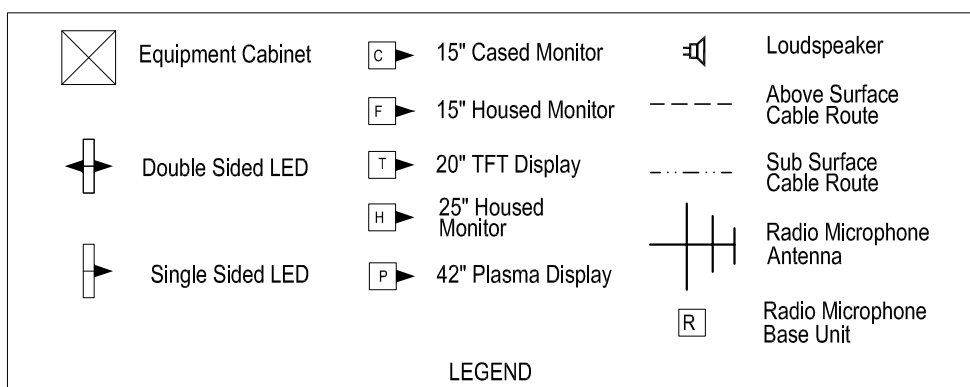

Equipment	Dist Board	
CIS RACK	S&T DB	R3
PT9-DSPI-002	GP 2	R1
PT10-DSPI-001	GP 2	R1
OTHERS EXISTING		

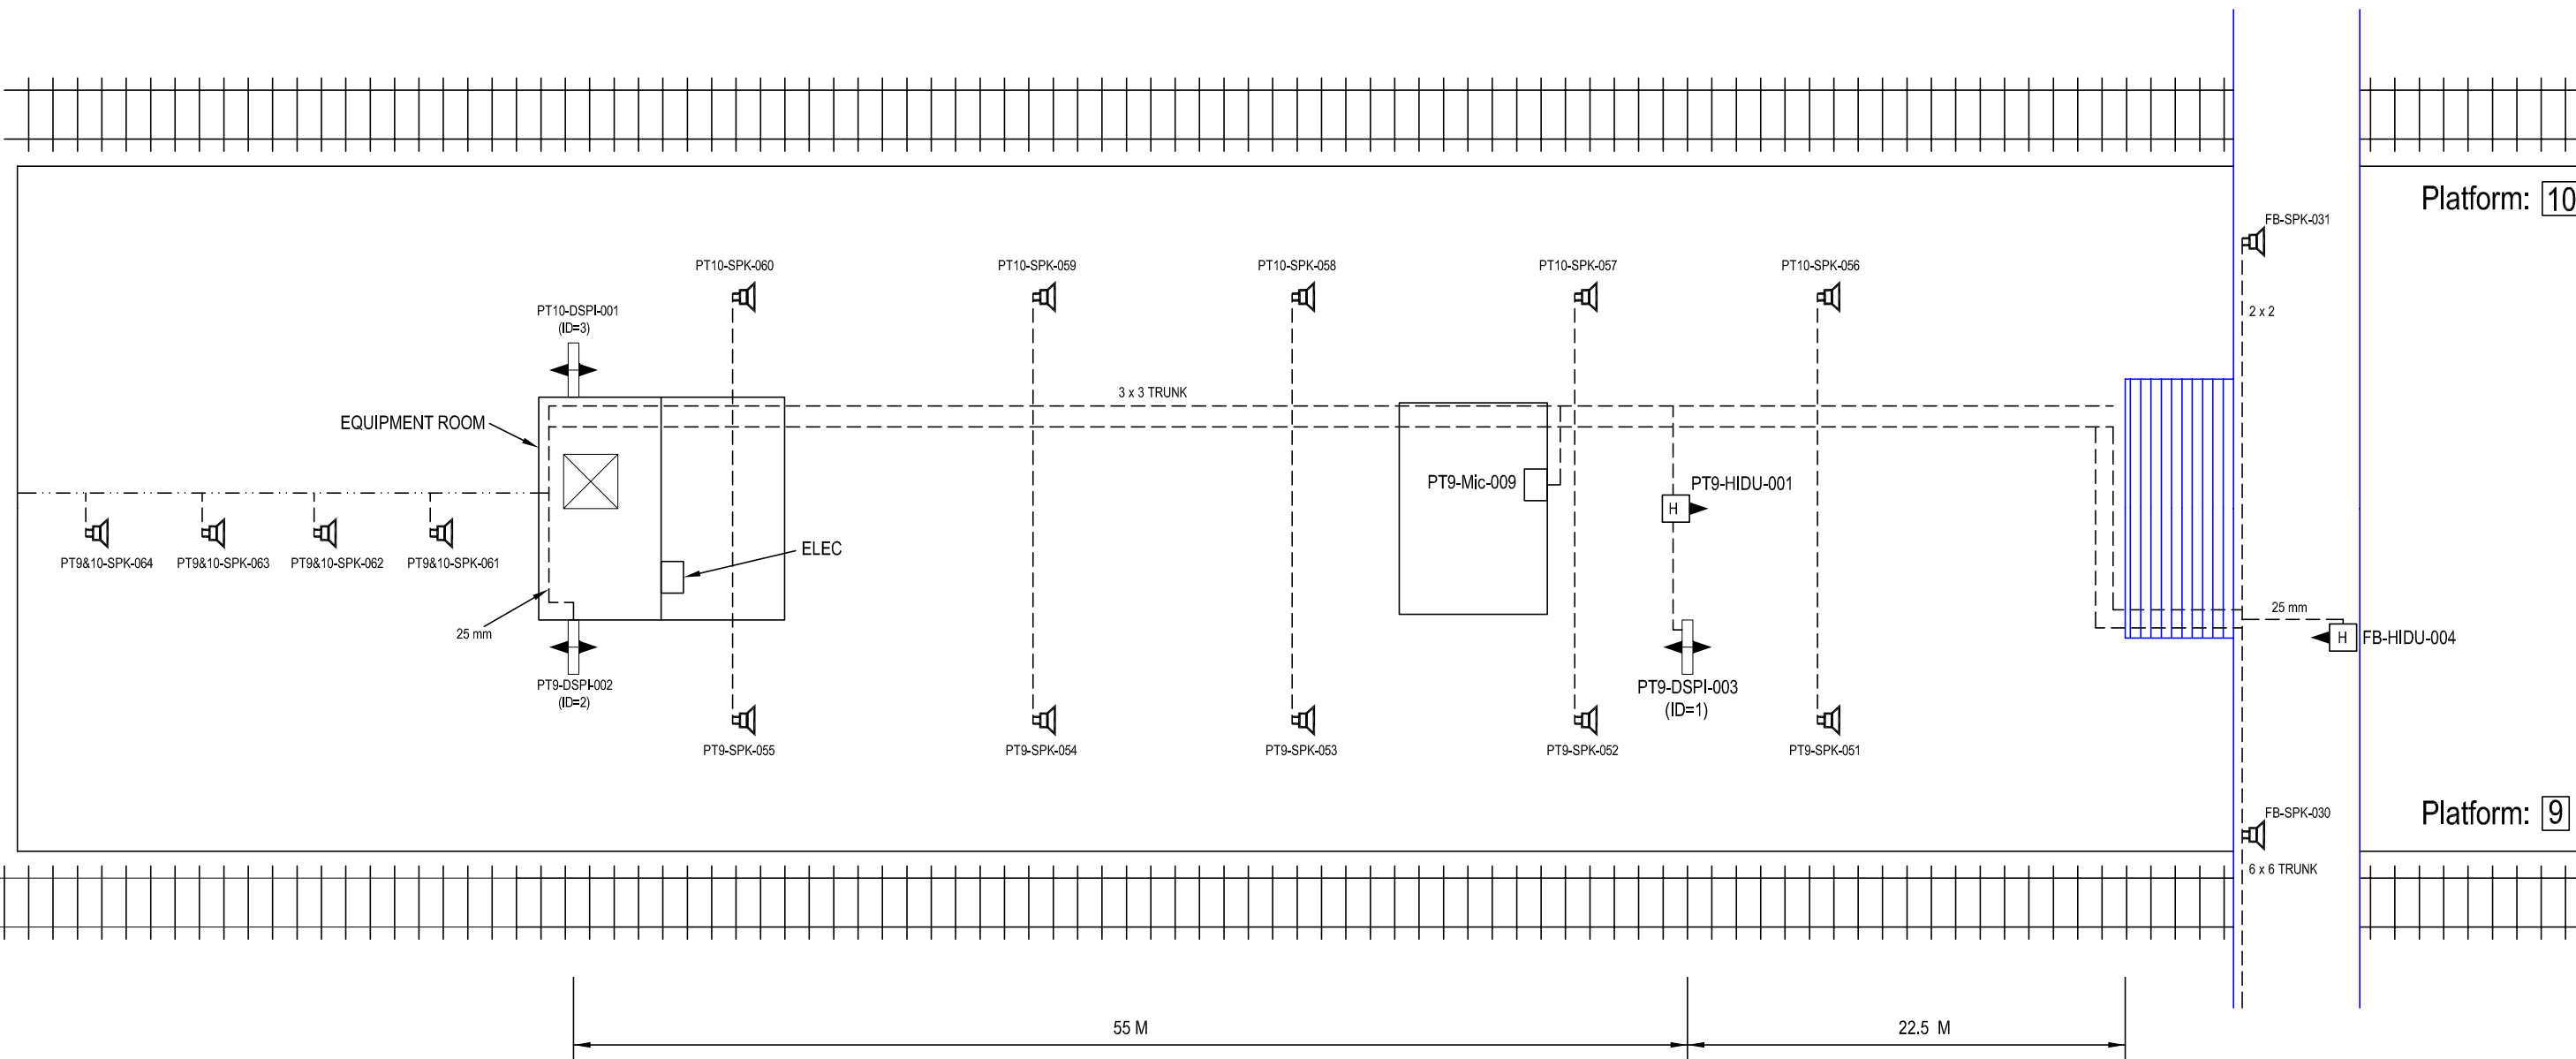

IF IN DOUBT ASK!

Date of Last Modification: 25 April 2003

This Drawing Supersedes Any Previous Drawings

CONSTRUCTION

	NAME	SIGNATURE	DATE
DRAWN BY	J STEVENS		25-04-2003
CHECKED BY	T WONG		
APPD BY	A SMITH		
APPD BY			
CAD Ref:			
CONTRACTOR'S Ref:			



AMEY DATEL Project Offices
1st Floor, Platform 2/3
Eastleigh Station
Southampton Road
Eastleigh
Hants
SO50 9FL

SITE/PROJECT

SOUTH WEST TRAINS CIS PROJECT

TITLE

WIMBLEDON
PLATFORMS 9 & 10
AS BUILT

SCALE

NTS

DRG No.

SM803-75578

ISSUE

C

SHEET

5 of 5

COPYRIGHT © AMEY Rail
All rights reserved. Neither this drawing or any of the information it contains may be copied or communicated to third parties without the written permission of the copyright holder