



WAN	
CIRCUIT ID	KXIP 900444
IP ADDRESS	10.227.38.1

"PLATFORM 1 HP ISDN"
01-189-797002
"PLATFORM 2 HP ISDN"
01-189-797003

All Equipment tags to be prefixed with "WKM-"

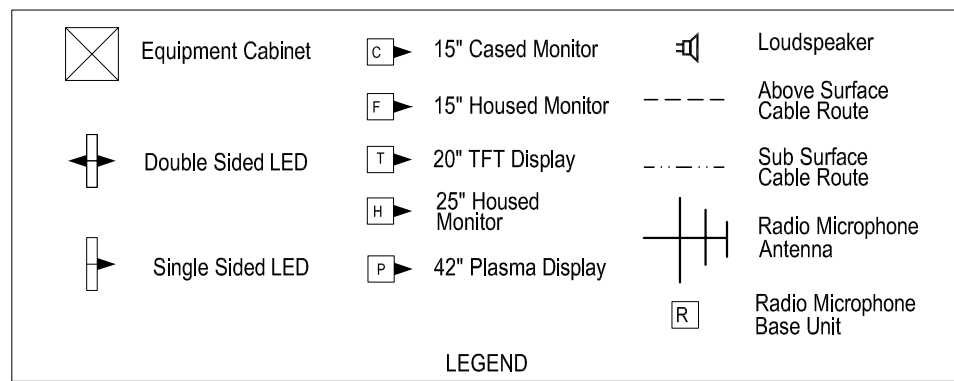

Equipment	Dist Board
PT1 DSPI	DB L2 BREAKER 11
PT2 DSPI	EQUIPMENT ROOM DB BREAKER 5

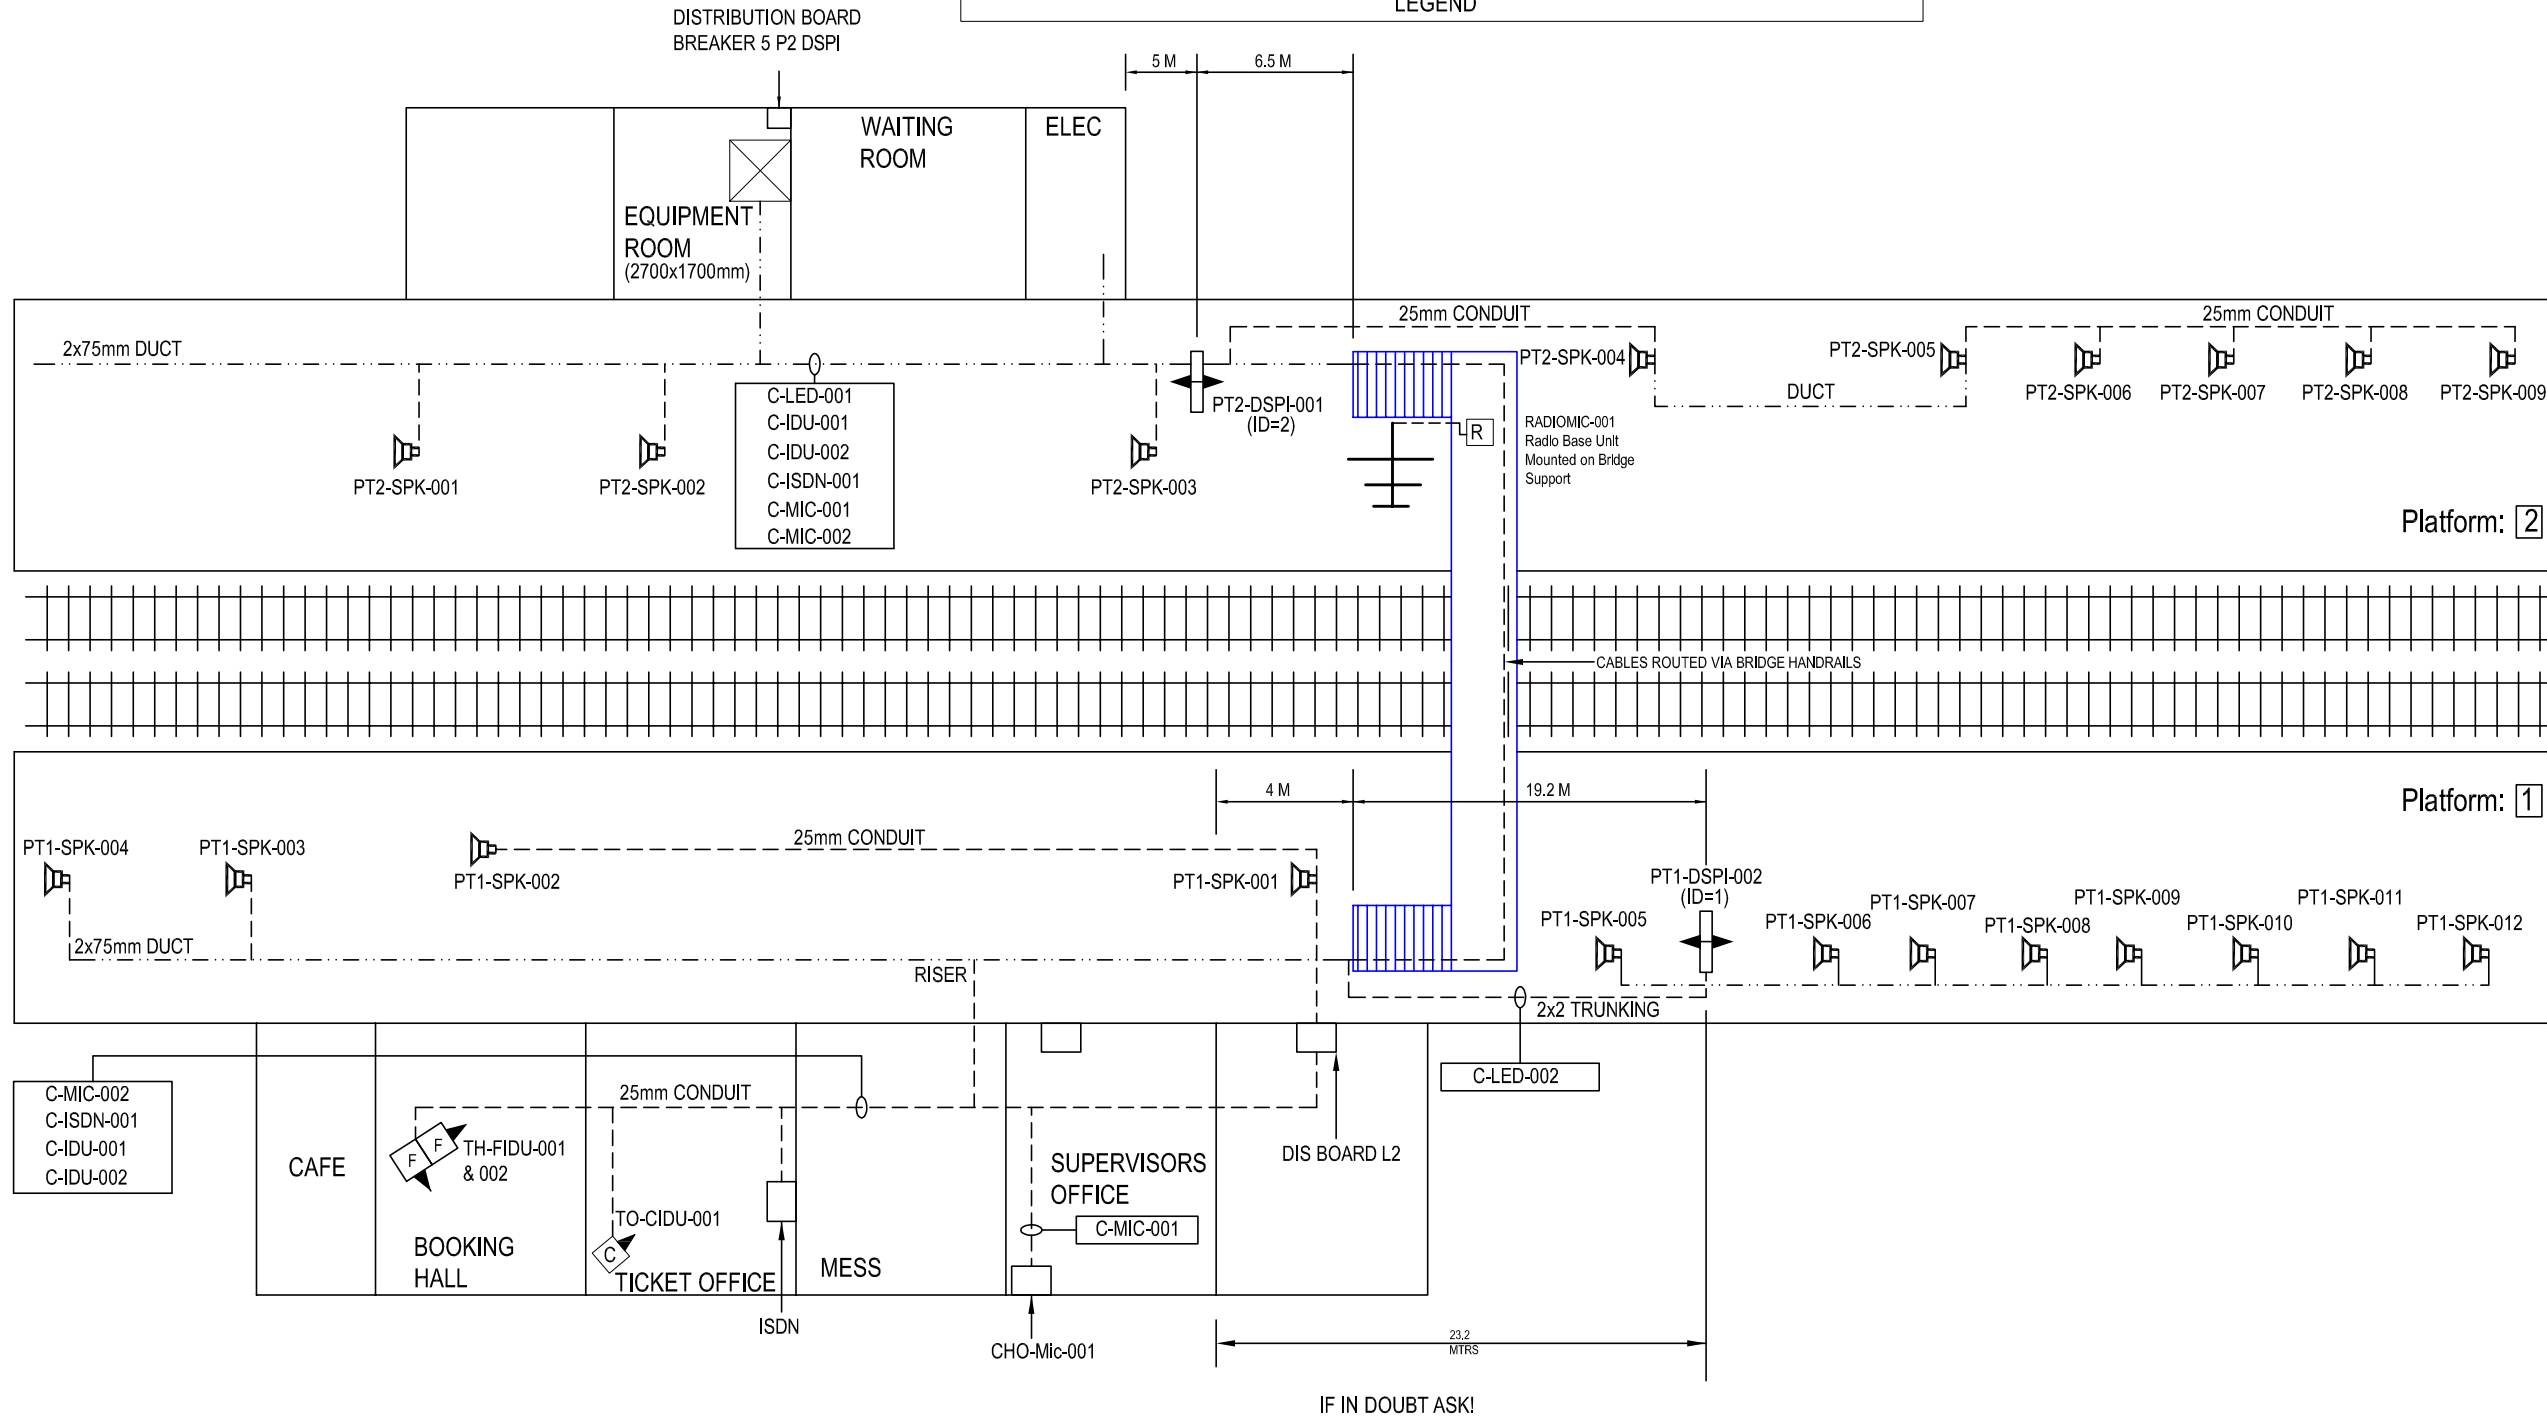

IF IN DOUBT ASK!

MATERIAL	CONSTRUCTION	NAME	SIGNATURE	DATE	AMEY DATEL Project Offices 1st Floor, Platform 2/3 Eastleigh Station Southampton Road Eastleigh Hants SO50 9FL	SITE/PROJECT		SOUTH WEST TRAINS CIS PROJECT	
		DRAWN BY	D GADDU	07-02-2002		TITLE		WOKINGHAM AS BUILT	
FINISH	CONSTRUCTION	CHECKED BY	T WONG		COPYRIGHT © AMEY Rail All rights reserved. Neither this drawing or any of the information it contains may be copied or communicated to third parties without the written permission of the copyright holder	SCALE	DRG No.	ISSUE	SHEET
		APPD BY	A SMITH			NTS	SM803-75696	B	1 of 1
		CAD Ref:							
		CONTRACTOR'S Ref:							