


DRG No.

SM803-75884


WAN	
CIRCUIT ID	KXIP 900446
IP ADDRESS	10.227.233.1

"PLATFORM 1 HP ISDN"
02380-444426
"PLATFORM 2 HP ISDN"
02380-444437

All Equipment tags to be prefixed with "WLS-"

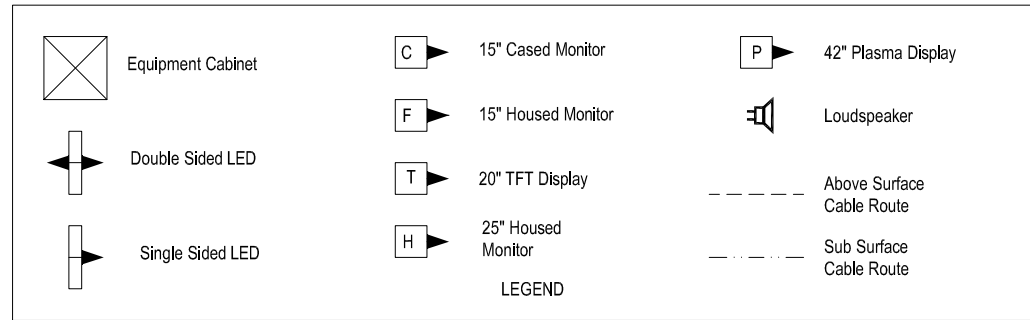

Equipment	Dist Board
CIS RACK	CCT NO. 1
13 AMP TWIN	CCT NO. 2
HEATER	CCT NO. 3
LIGHT	CCT NO. 4
STAT & FAN	CCT NO. 5
LED PT2	CCT NO. 6

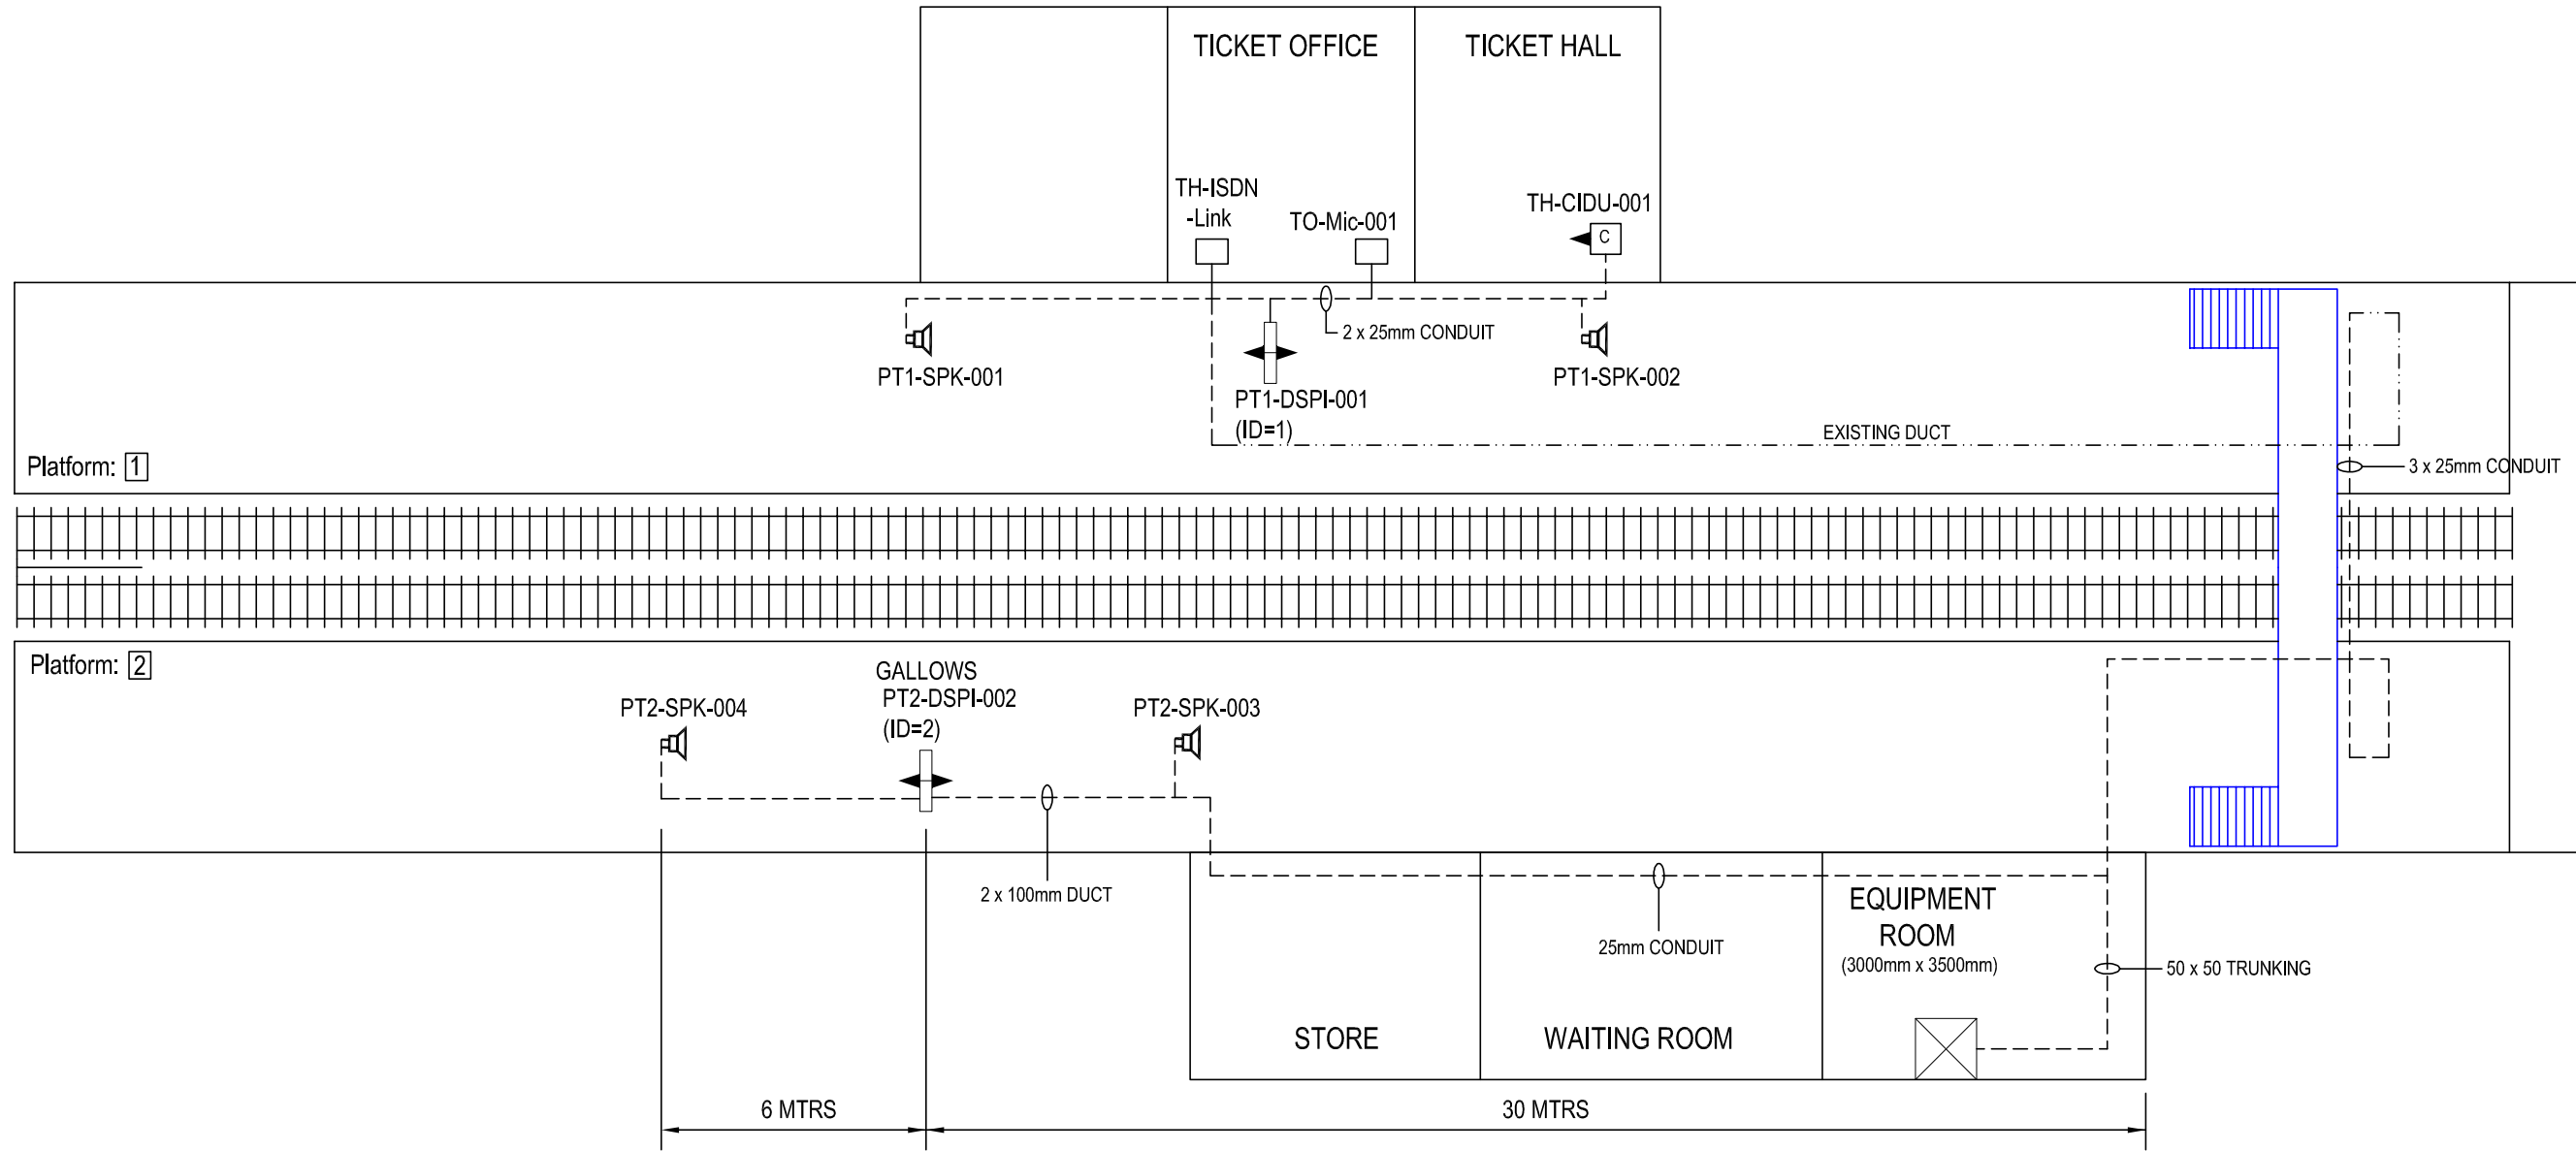

IF IN DOUBT ASK!

MATERIAL	CONSTRUCTION	NAME	SIGNATURE	DATE
		D GADDU		01-04-2002
		T WONG		
		A SMITH		
FINISH				
		CAD Ref:		
		CONTRACTOR'S Ref:		

AMEY DATEL Project  
 Offices  
 1st Floor, Platform  
 2/3  
 Eastleigh Station  
 Southampton Road  
 Eastleigh  
 Hants  
 SO50 9FL

COPYRIGHT © AMEY Rail  
 All rights reserved. Neither this drawing or any of the information it contains may be copied or communicated to third parties without the written permission of the copyright holder

SITE/PROJECT		SOUTH WEST TRAINS CIS PROJECT	
TITLE		WOOLSTON AS BUILT	
SCALE	DRG No.	ISSUE	SHEET
NTS	SM803-75884	B	1 of 1