


DRG No.

SM803-75528


WAN	
CIRCUIT ID	KXIP900439
IP ADDRESS	10.227.228.1

"PLATFORM 1 HP ISDN"
01-252-844767
"PLATFORM 2 HP ISDN"
01-252-844786

All Equipment tags to be prefixed with "WNF-"

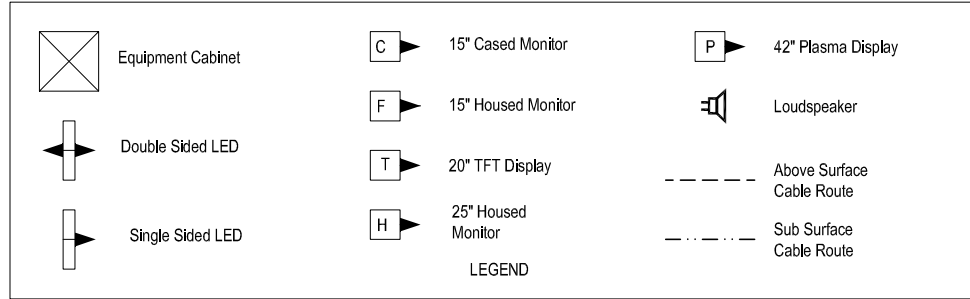


Equipment	Dist Board
CIS RACK	NEW BOARD
HEATER	CCT 2
EXTRACTOR FAN	CCT 4
OTHER EQUIPMENT	EXISTING SPURS

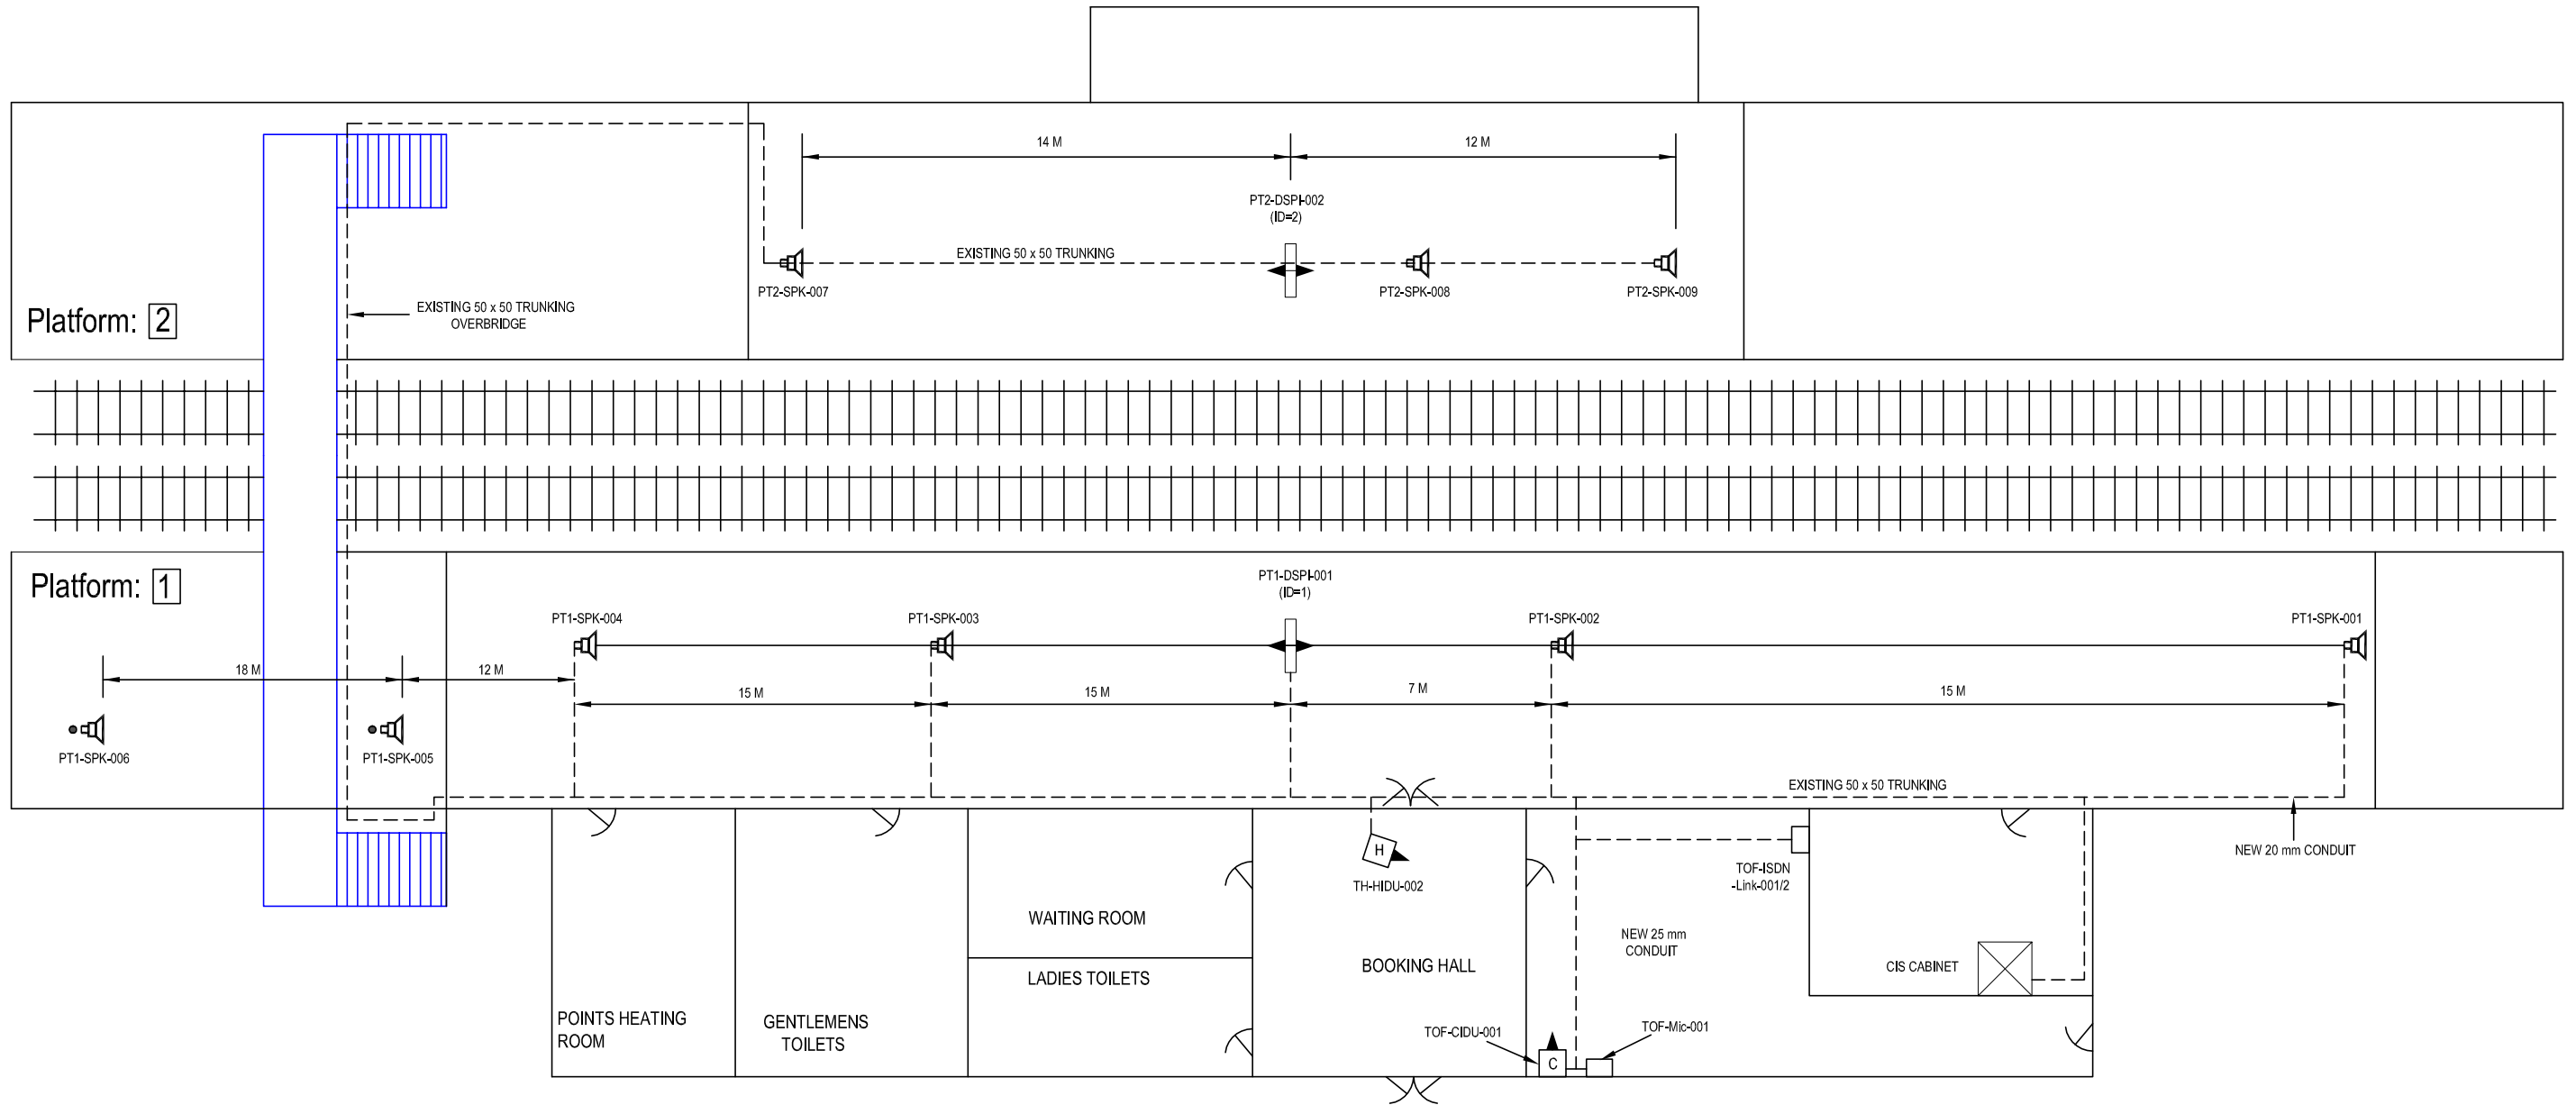

IF IN DOUBT ASK!

MATERIAL	
FINISH	

CONSTRUCTION	NAME	SIGNATURE	DATE
DRAWN BY	D GADDU		30-05-2002
CHECKED BY	T WONG		
APPD BY	A SMITH		
APPD BY			
CAD Ref:			
CONTRACTOR'S Ref:			



AMEY DATEL Project
 Offices
 1st Floor, Platform
 2/3
 Eastleigh Station
 Southampton Road
 Eastleigh
 Hants
 SO50 9FL

COPYRIGHT © AMEY Rail
 All rights reserved. Neither this drawing or any of the information
 it contains may be copied or communicated to third parties
 without the written permission of the copyright holder

SITE/PROJECT		SOUTH WEST TRAINS CIS PROJECT	
TITLE		WINCHFIELD AS BUILT	
SCALE	DRG No.	ISSUE	SHEET
NTS	SM803-75528	B	1 of 1