



WAN	
CIRCUIT ID	KXIP 900442
IP ADDRESS	10.227.229.1

"PLATFORM 1 HP ISDN"
01-189-770073
"PLATFORM 2 HP ISDN"
01-189-770074


All Equipment tags to be prefixed with "WNS-"

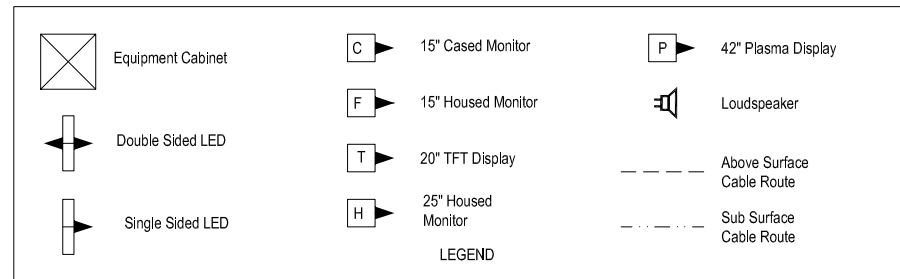

Equipment	Dist Board
PT1 DSPI	PT1 DB BREAKER 5
TOF MONITOR	ELEC. ROOM DB BREAKER 2
PT2 DSPI	BREAKER 3

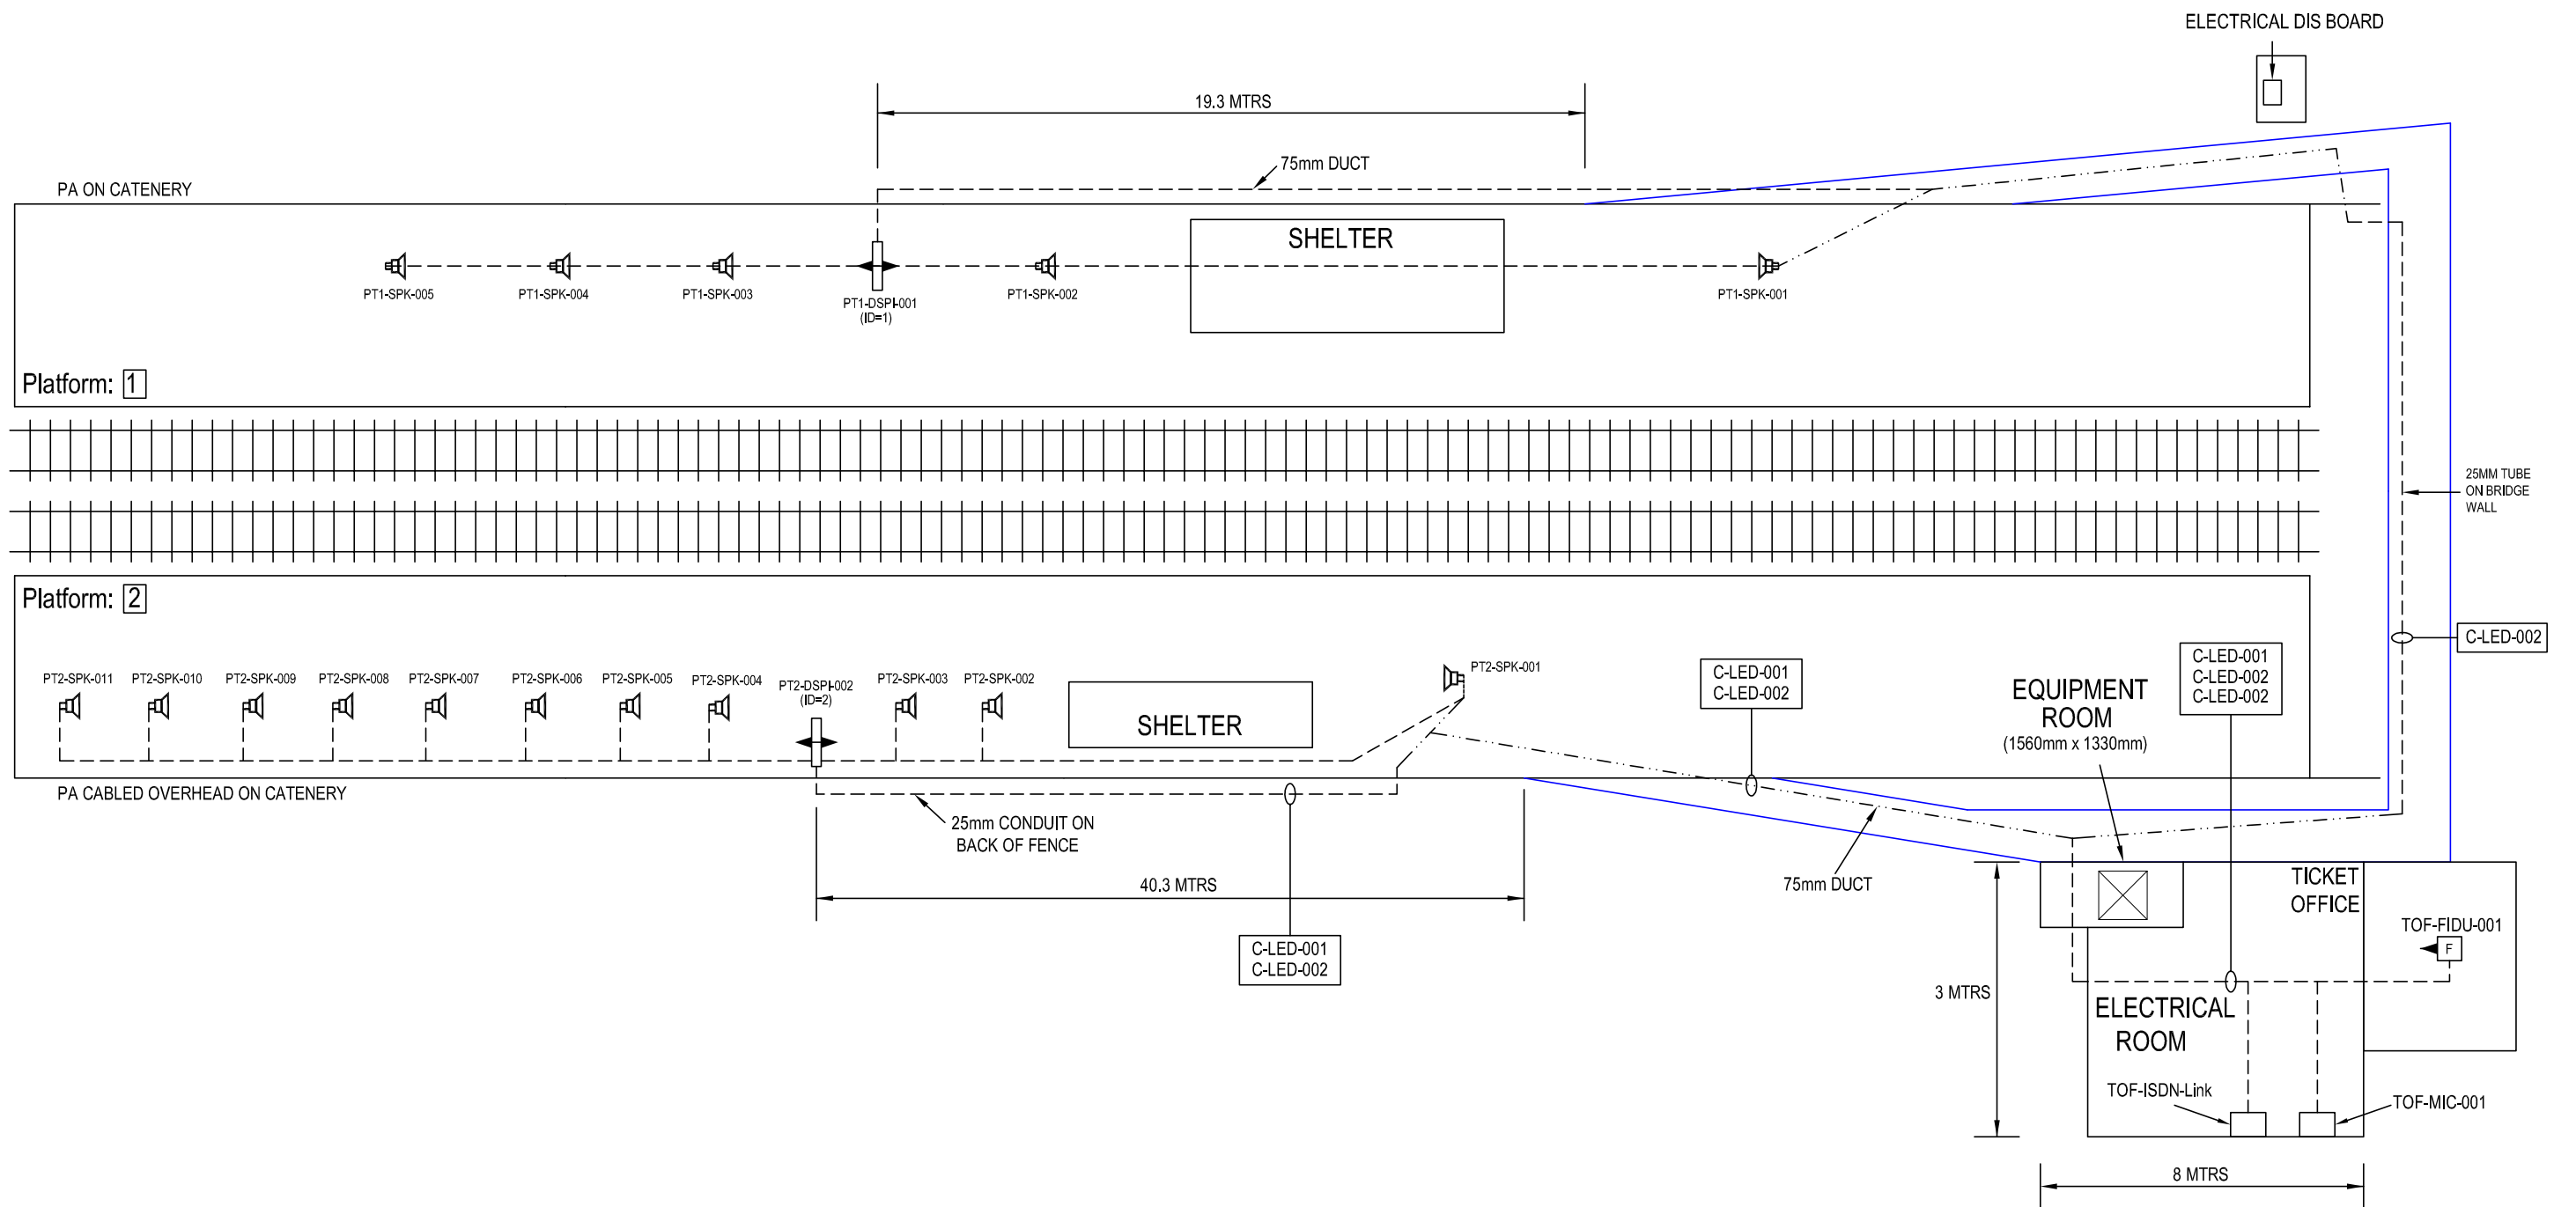

IF IN DOUBT ASK!

MATERIAL	CONSTRUCTION	DRAWN BY			 AMEY DATEL Project Offices 1st Floor, Platform 2/3 Eastleigh Station Southampton Road Eastleigh Hants SO50 9FL	SITE/PROJECT		
		NAME	SIGNATURE			SOUTH WEST TRAINS CIS PROJECT		
		DRAWN BY	D GADDU	21-02-2002		TITLE		
		CHECKED BY	T WONG			WINNERSH AS BUILT		
		APPD BY	A SMITH		SCALE	DRG No.	ISSUE	SHEET
FINISH		CONTRACTOR'S Ref:			NTS	SM803-75697	B	1 of 1

COPYRIGHT © AMEY Rail
 All rights reserved. Neither this drawing or any of the information
 it contains may copied or communicated to third parties
 without the written permission of the copyright holder