


DRG No. SM803-75576


WAN	
CIRCUIT ID	KXIP600420
IP ADDRESS	10.227.118.1

"PLATFORM 1 HP ISDN"
020-8870-2324
"PLATFORM 2 HP ISDN"
020-8870-2471

All Equipment tags to be prefixed with "WNT-"

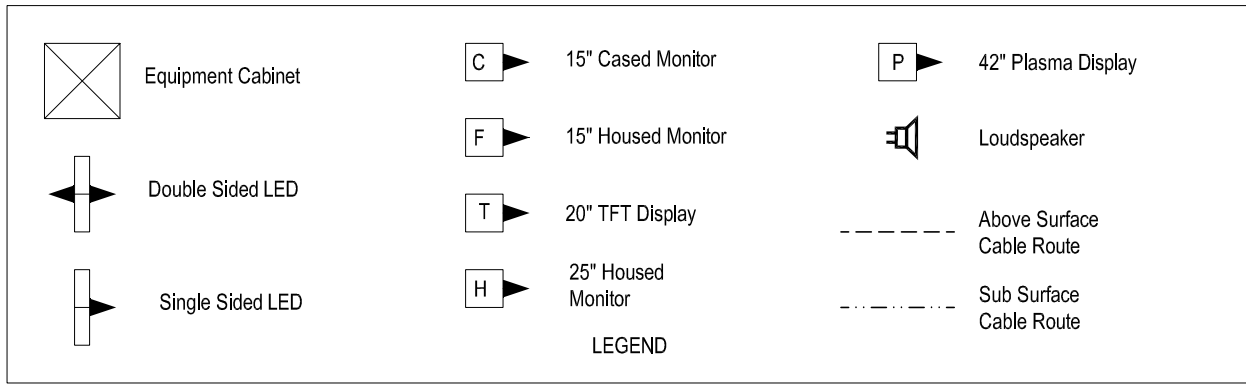

Equipment	Dist Board
CIS RACK	NEW BOARD FROM GP1 CCT9
OTHERS	EXISTING SUPPLIES EXTENDED

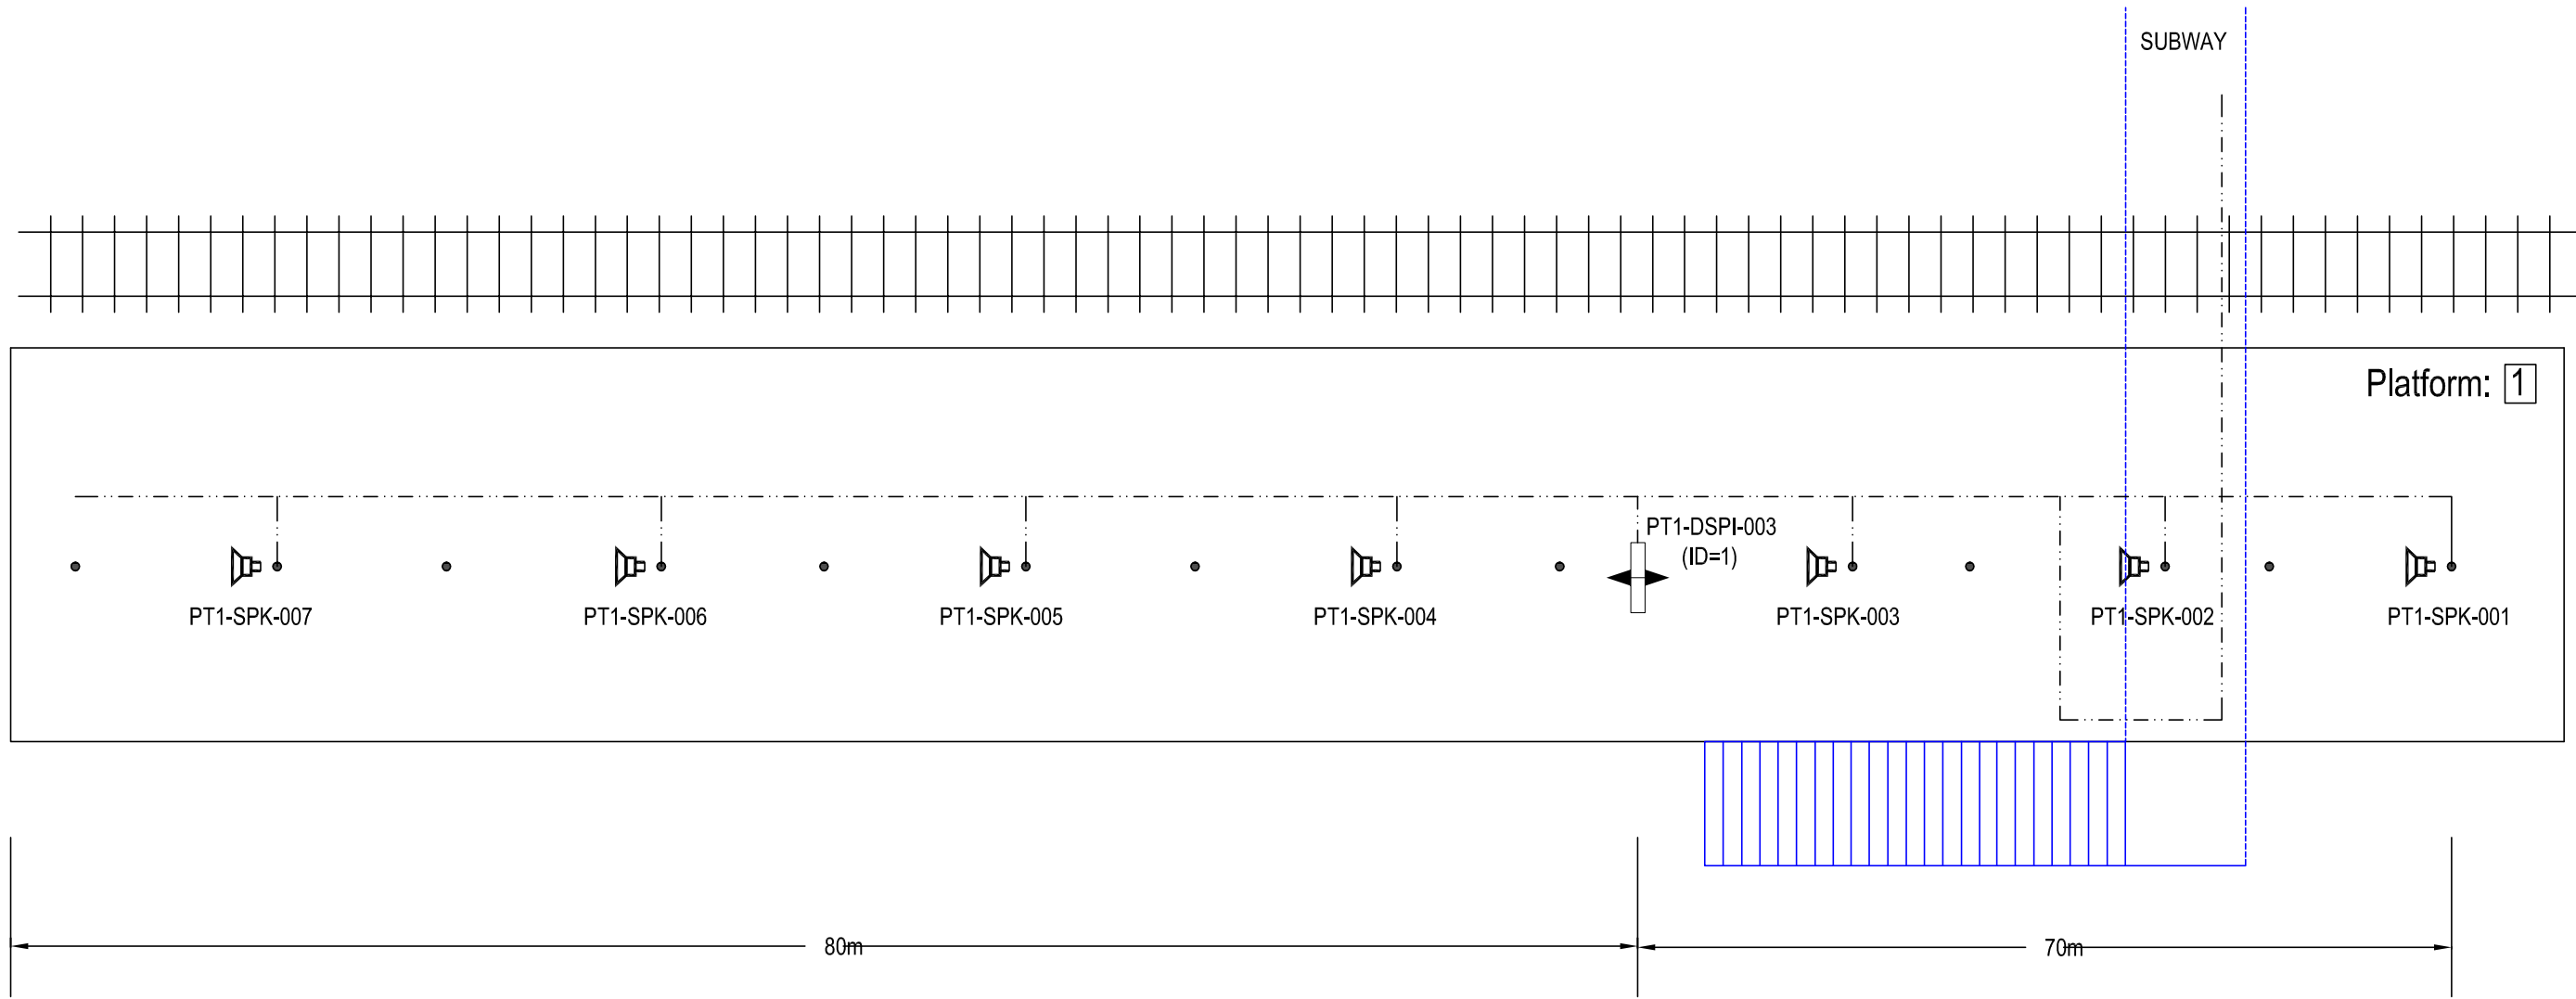

IF IN DOUBT ASK!

Date of Last Modification: 25 April 2003

This Drawing Supersedes Any Previous Drawings

CONSTRUCTION	NAME	SIGNATURE	DATE
DRAWN BY	J STEVENS		25-04-2003
CHECKED BY	T WONG		
APPD BY	A SMITH		
APPD BY			
CAD Ref:			
CONTRACTOR'S Ref:			

AMEY DATEL Project  
Offices  
1st Floor, Platform  
2/3  
Eastleigh Station  
Southampton Road  
Eastleigh  
Hants  
SO50 9FL

COPYRIGHT © AMEY Rail  
All rights reserved. Neither this drawing or any of the information it contains may be copied or communicated to third parties without the written permission of the copyright holder

SITE/PROJECT		SOUTH WEST TRAINS CIS PROJECT	
TITLE		WANDSWORTH TOWN AS BUILT	
SCALE	DRG No.	ISSUE	SHEET
NTS	SM803-75576	C	1 of 3

"PLATFORM 1 HP ISDN"
020-8870-2324
"PLATFORM 2 HP ISDN"
020-8870-2471

WAN	
CIRCUIT ID	KXIP600420
IP ADDRESS	10.227.118.1

Equipment Cabinet

Double Sided LED

Single Sided LED

C 15" Cased Monitor

F 15" Housed Monitor

T 20" TFT Display

H 25" Housed Monitor

P 42" Plasma Display

Loudspeaker



--- Above Surface Cable Route

--- Sub Surface Cable Route

LEGEND

Equipment	Dist Board
CIS RACK	NEW BOARD FROM GP1 CCT9
OTHERS	EXISTING SUPPLIES EXTENDED

All Equipment tags to be prefixed with "WNT-"

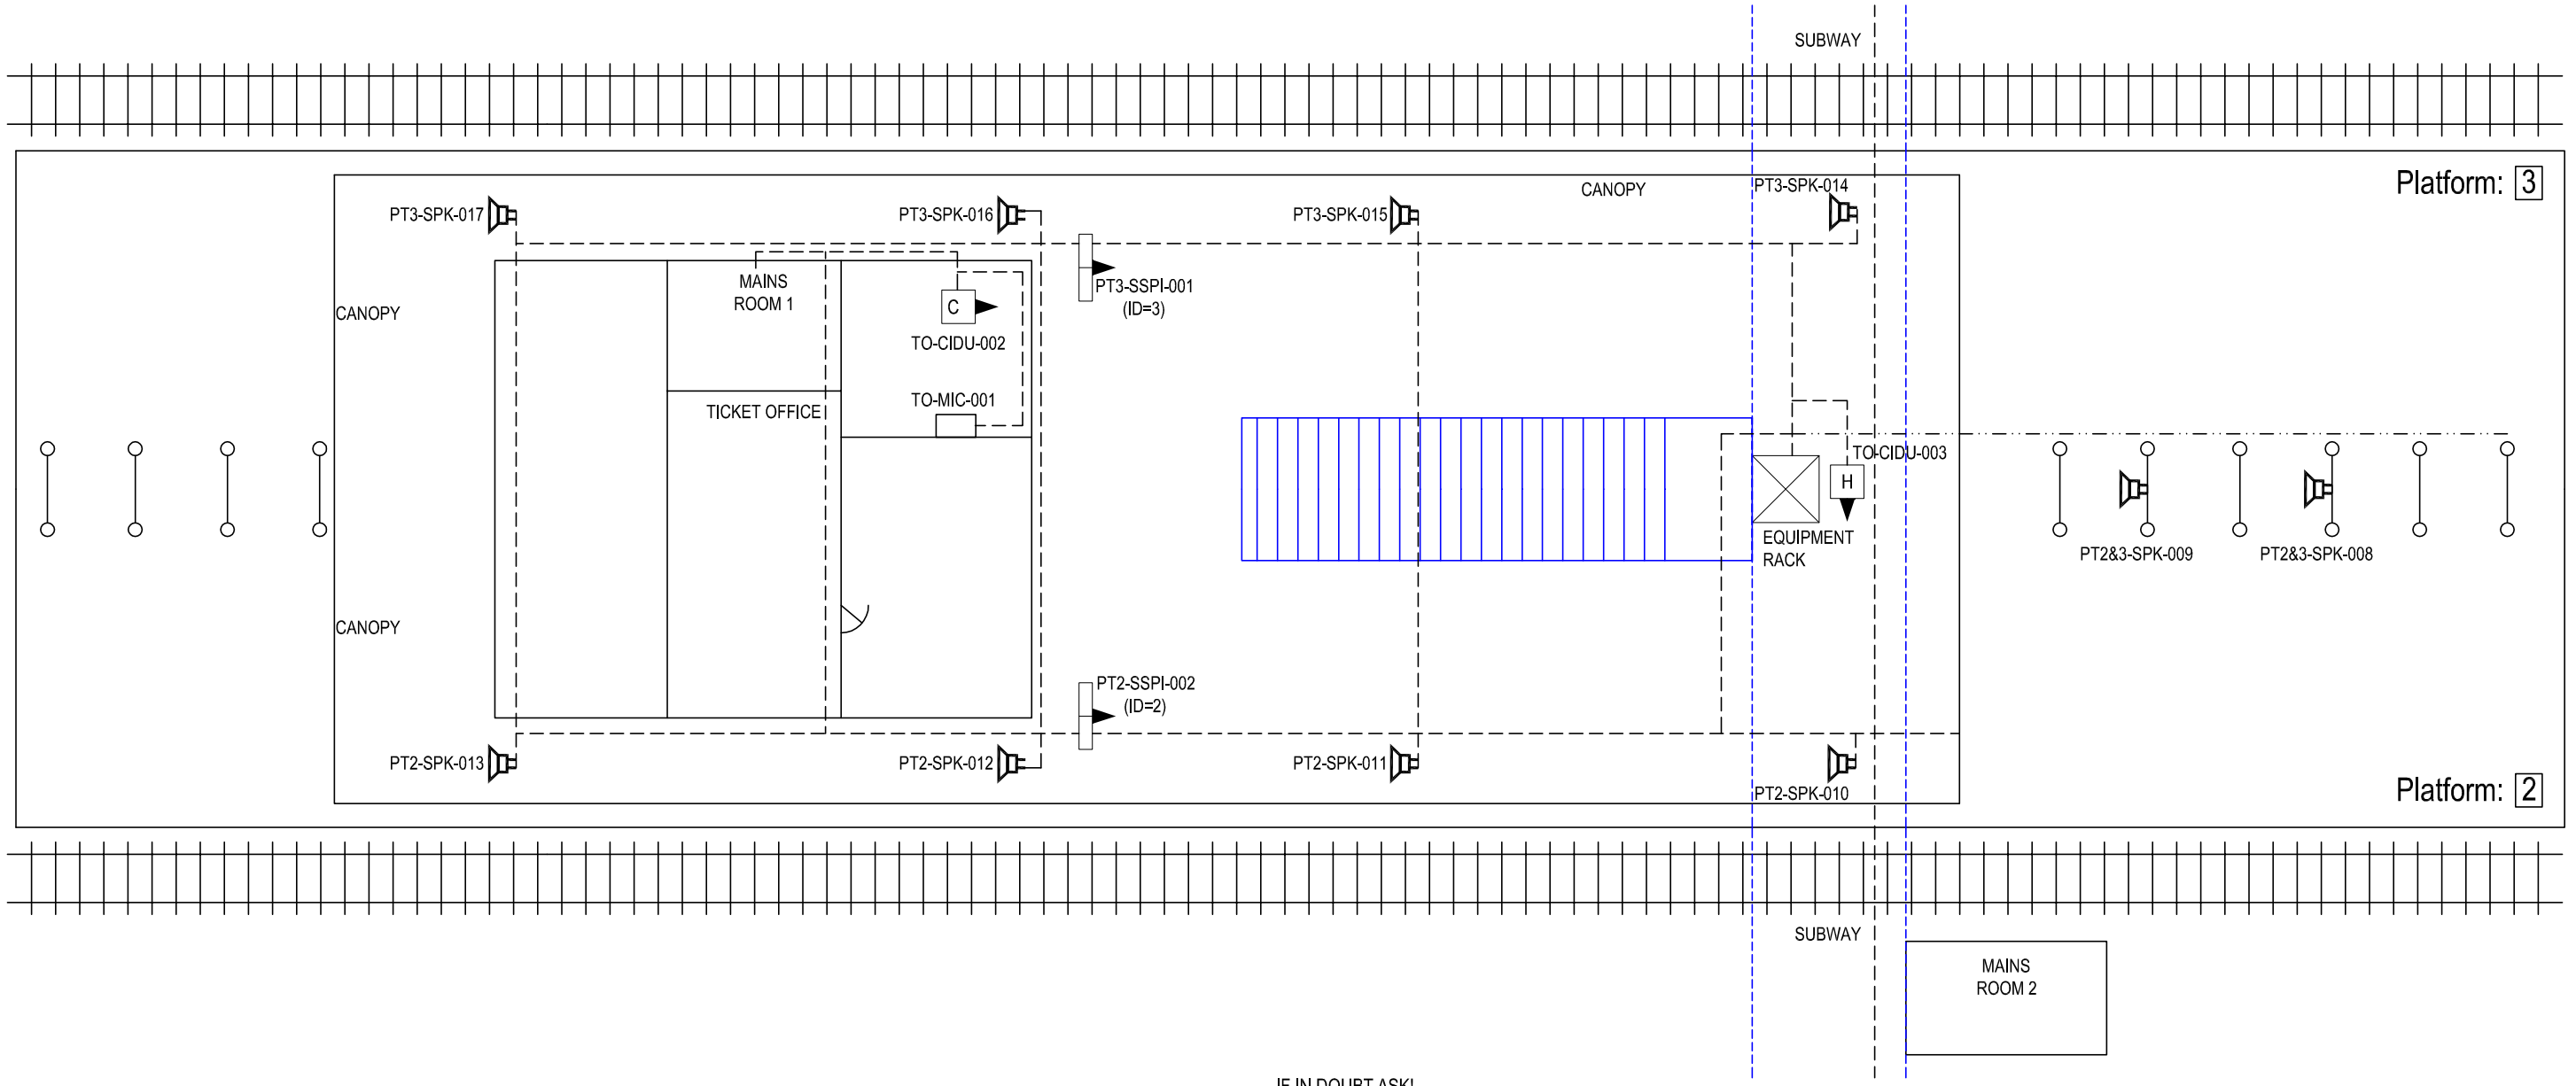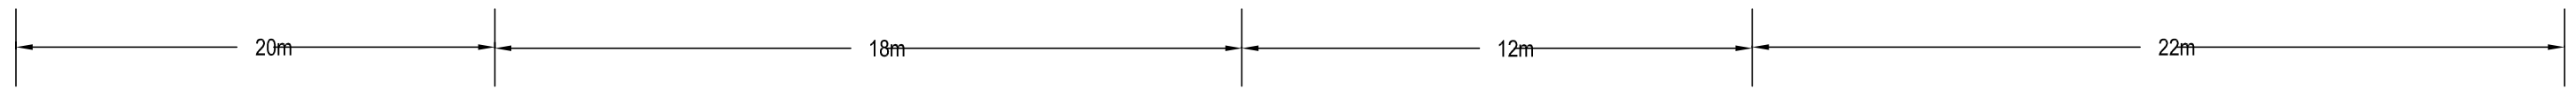

IF IN DOUBT ASK!

Date of Last Modification: 25 April 2003

This Drawing Supersedes Any Previous Drawings

CONSTRUCTION	NAME	SIGNATURE	DATE
DRAWN BY	J STEVENS		25-04-2003
CHECKED BY	T WONG		
APPD BY	A SMITH		
APPD BY			

AMEY DATEL Project  
Offices  
1st Floor, Platform  
2/3  
Eastleigh Station  
Southampton Road  
Eastleigh  
Hants  
SO50 9FL

SITE/PROJECT		SOUTH WEST TRAINS CIS PROJECT	
TITLE		WANDSWORTH TOWN AS BUILT	

FINISH


CAD Ref:	
CONTRACTOR'S Ref:	

COPYRIGHT © AMEY Rail  
All rights reserved. Neither this drawing or any of the information it contains may be copied or communicated to third parties without the written permission of the copyright holder

SCALE	DRG No.	ISSUE	SHEET
NTS	SM803-75576	D	2 of 3

DRG No. SM803-75576



"PLATFORM 1 HP ISDN"
020-8870-2324
"PLATFORM 2 HP ISDN"
020-8870-2471

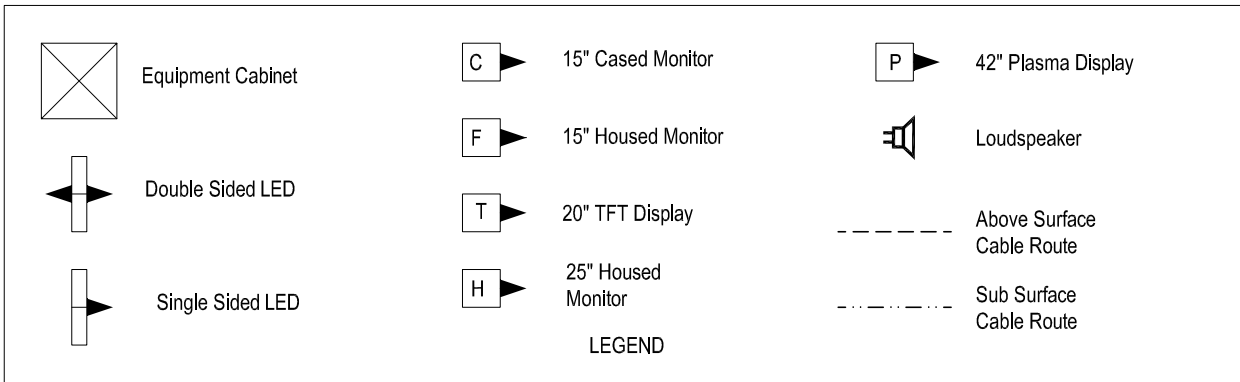

Equipment	Dist Board
CIS RACK	NEW BOARD FROM GP1 CCT9
OTHERS	EXISTING SUPPLIES EXTENDED

WAN	
CIRCUIT ID	KXIP600420
IP ADDRESS	10.227.118.1


All Equipment tags to be prefixed with "WNT-"

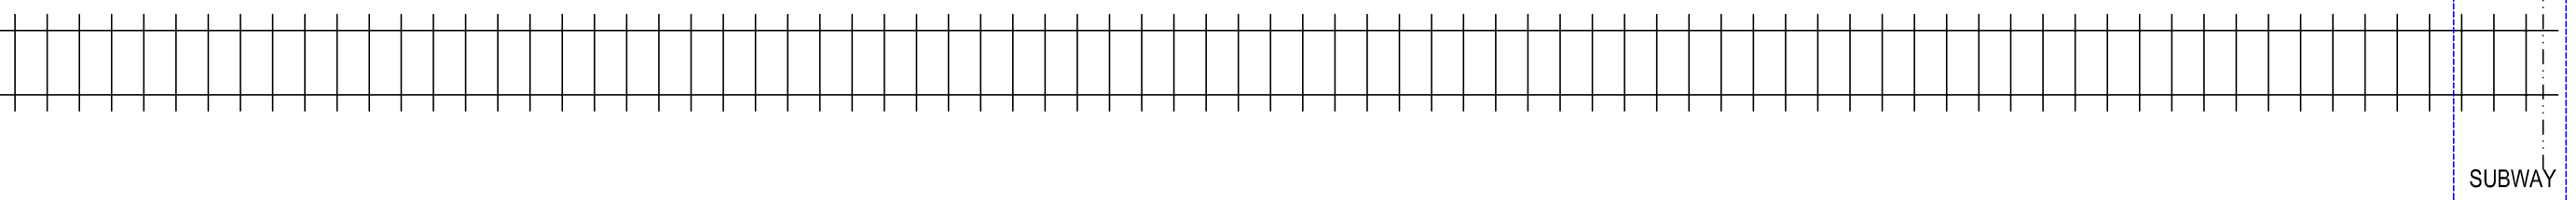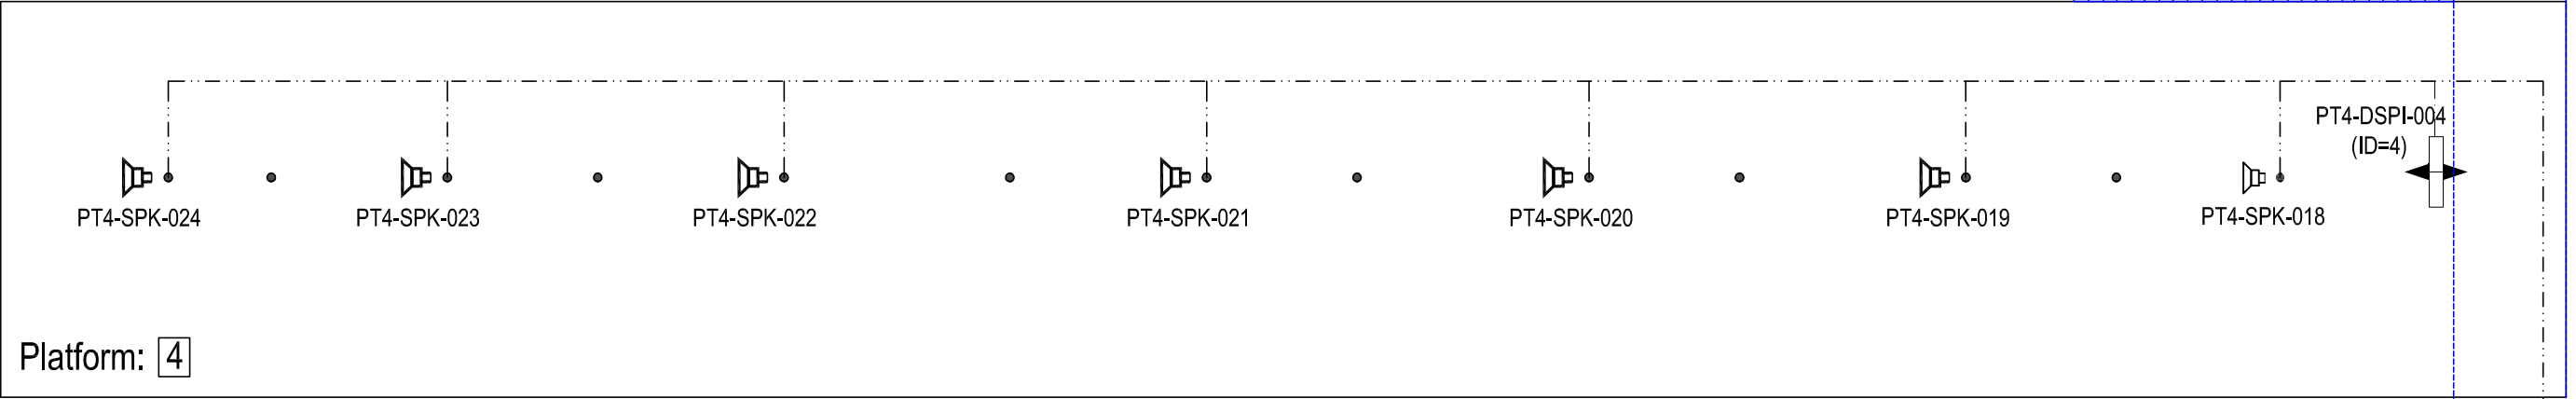

IF IN DOUBT ASK!

Date of Last Modification: 25 April 2003  
 This Drawing Supersedes Any Previous Drawings

CONSTRUCTION	NAME	SIGNATURE	DATE
DRAWN BY	J STEVENS		25-04-2003
CHECKED BY	T WONG		
APPD BY	A SMITH		
APPD BY			
CAD Ref:			
CONTRACTOR'S Ref:			



AMEY DATEL Project  
 Offices  
 1st Floor, Platform  
 2/3  
 Eastleigh Station  
 Southampton Road  
 Eastleigh  
 Hants  
 SO50 9FL

COPYRIGHT © AMEY Rail  
 All rights reserved. Neither this drawing or any of the information it contains may be copied or communicated to third parties without the written permission of the copyright holder

SITE/PROJECT		SOUTH WEST TRAINS CIS PROJECT	
TITLE		WANDSWORTH TOWN AS BUILT	
SCALE	DRG No.	ISSUE	SHEET
NTS	SM803-75576	C	3 of 3