



WAN	
CIRCUIT ID	KXIP 900445
IP ADDRESS	10.227.232.1

"PLATFORM 1 HP ISDN"
01-929-405765
"PLATFORM 2 HP ISDN"
01-929-405786

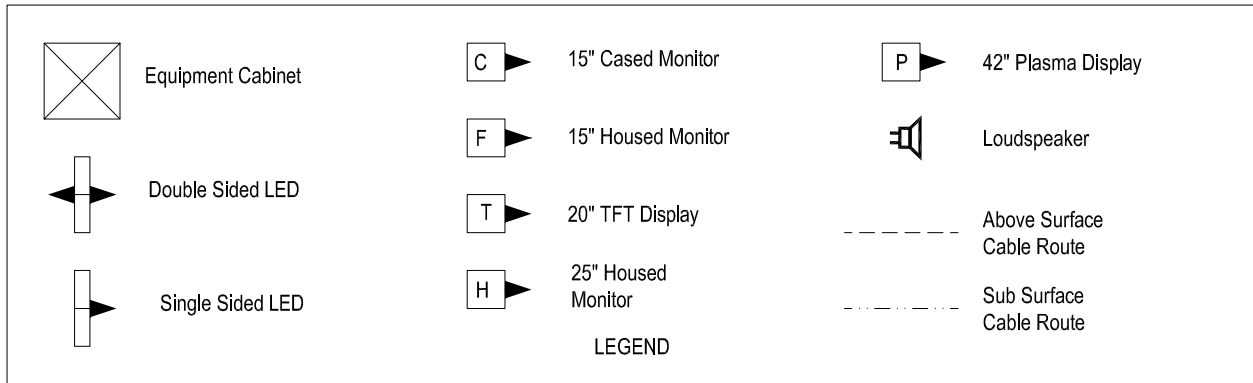

Equipment	Dist Board
CCT NO.1	CIS CAB
CCT NO.2	LED
CCT NO.3	LED
CCT NO.4	CRT

All Equipment tags to be prefixed with "WOO-"

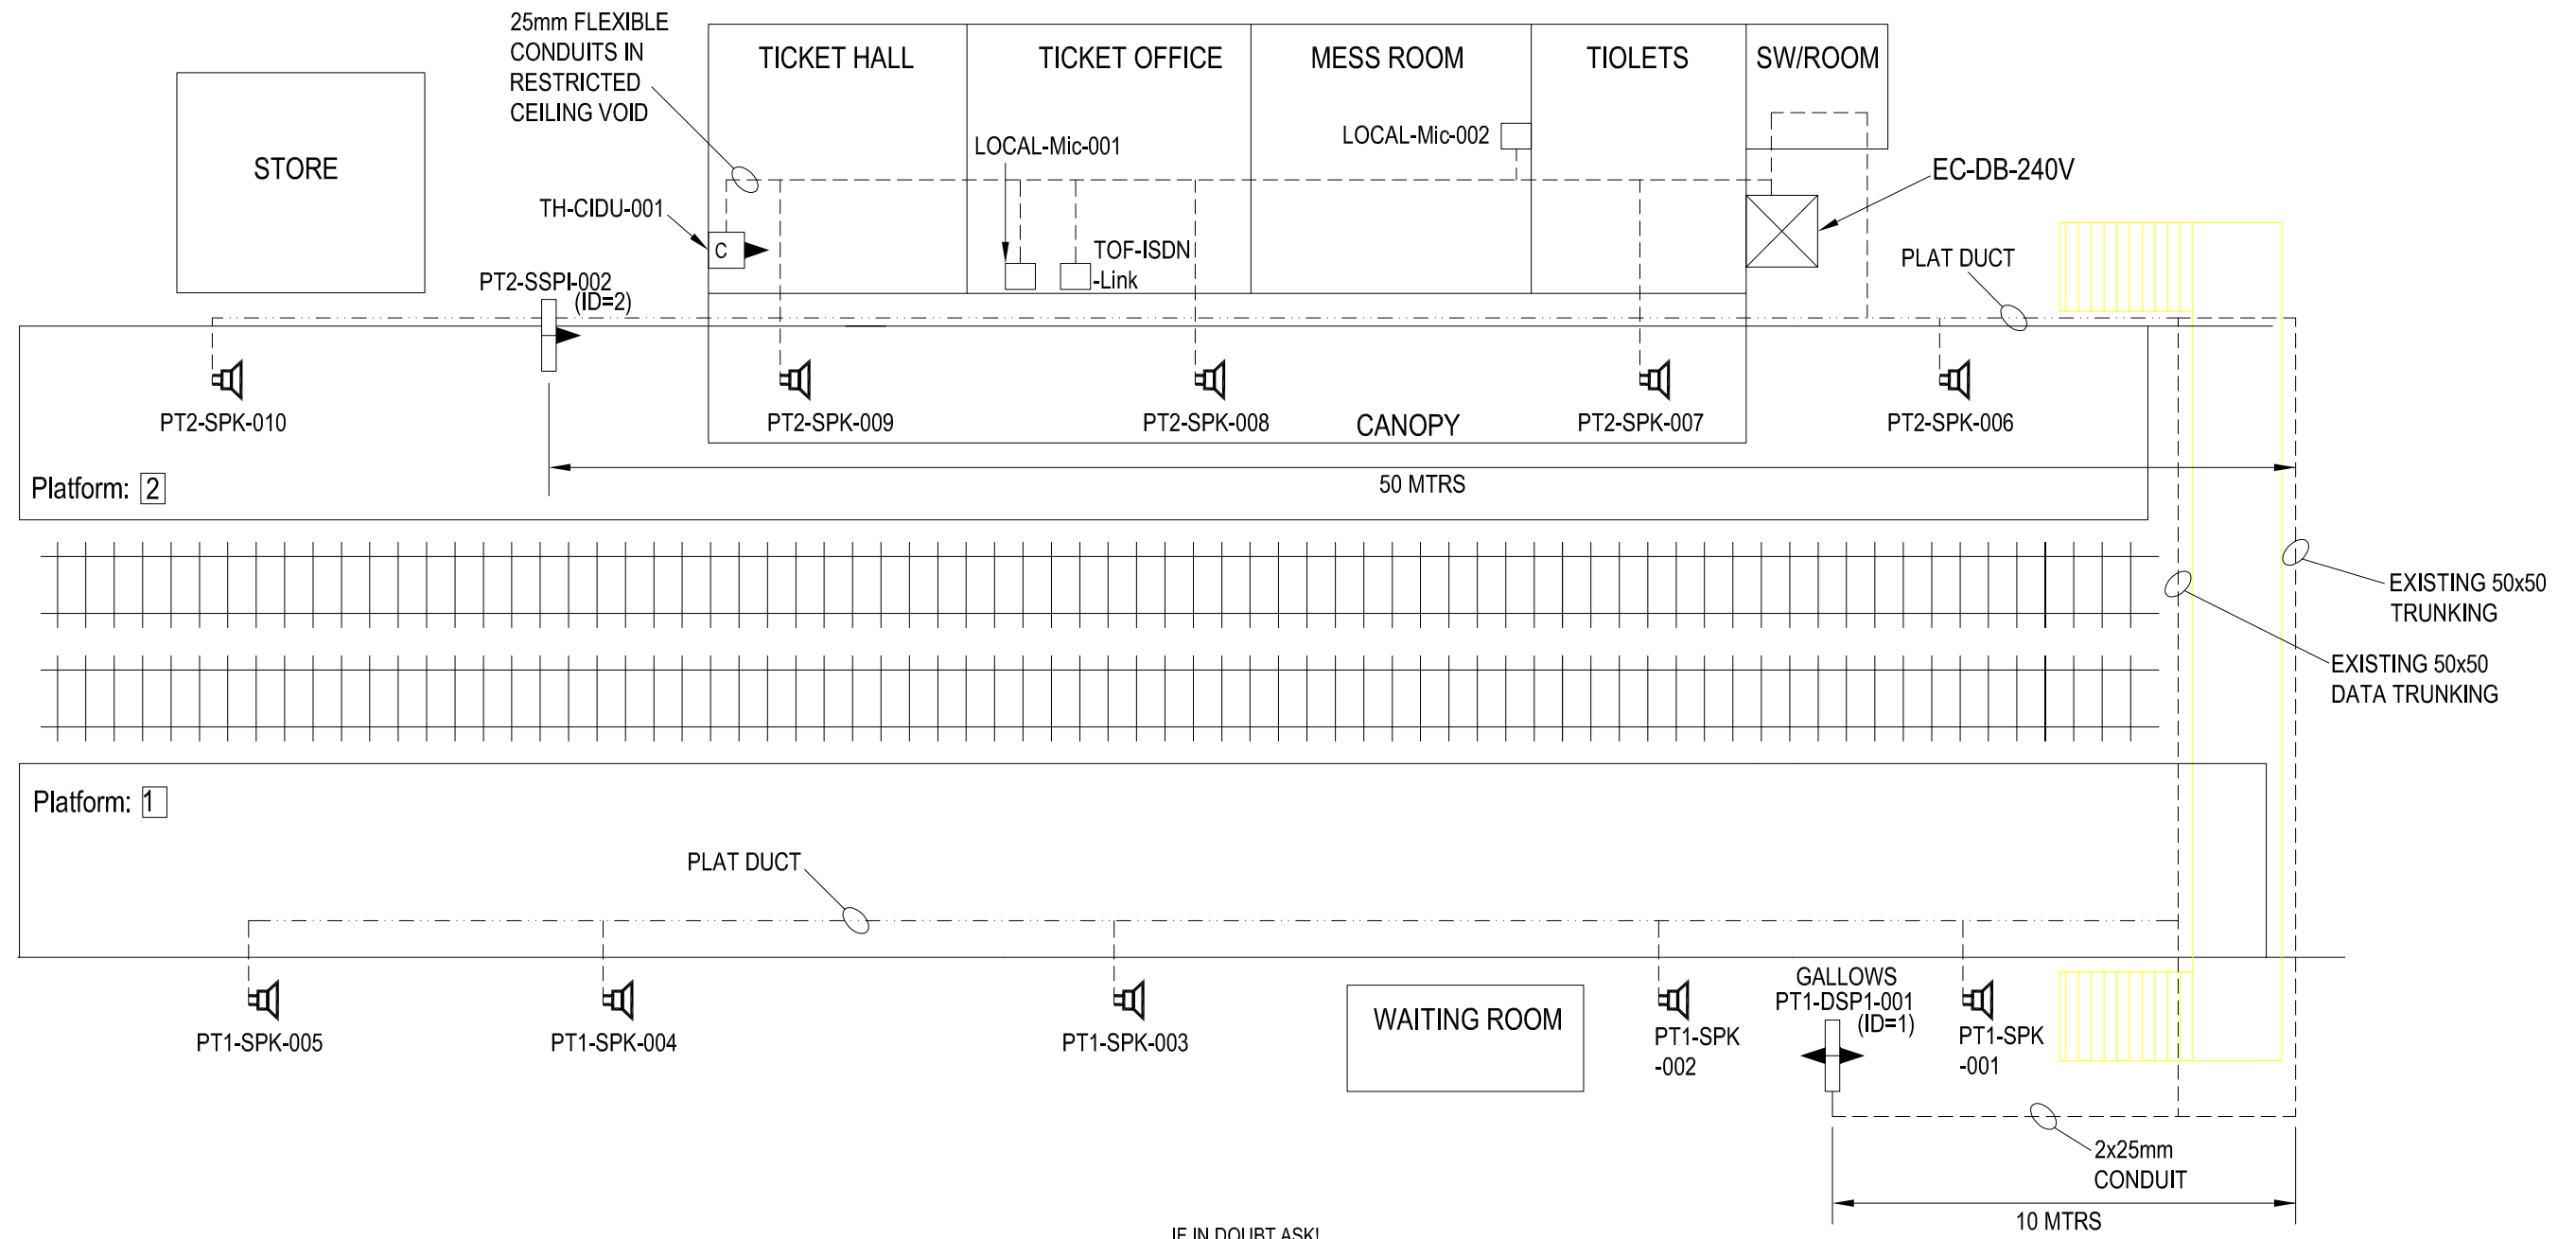

MATERIAL	CONSTRUCTION	DRAWN BY	D GADDU	SIGNATURE		<p>AMEY DATEL Project Offices 1st Floor, Platform 2/3 Eastleigh Station Southampton Road Eastleigh Hants SO50 9FL</p>	SITE/PROJECT			SOUTH WEST TRAINS CIS PROJECT		
		CHECKED BY					TITLE			WOOL AS BUILT		
		APPD BY					SCALE	DRG No.	ISSUE	SHEET		
		APPD BY					NTS	SM803-75960	B	1 of 1		
FINISH		CAD Ref:		CONTRACTOR'S Ref:		<p>COPYRIGHT © AMEY Rail All rights reserved. Neither this drawing or any of the information it contains may be copied or communicated to third parties without the written permission of the copyright holder</p>						