


DRG No. SM803-75686


WAN	
CIRCUIT ID	KXIP900448
IP ADDRESS	10.227.235.1

"PLATFORM 1 HP ISDN"
01-483-232090
"PLATFORM 2 HP ISDN"
01-483-232096


All Equipment tags to be prefixed with "WPL-"

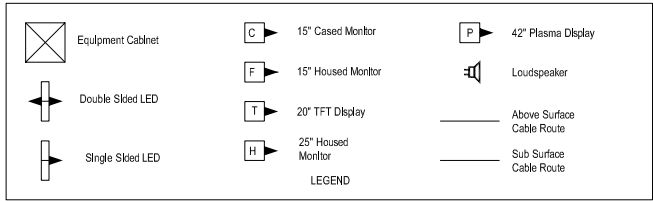

Equipment	Dist Board
CIS RACK	2
DSPL-001	5
SSPL-002	5
HIDU-001	6

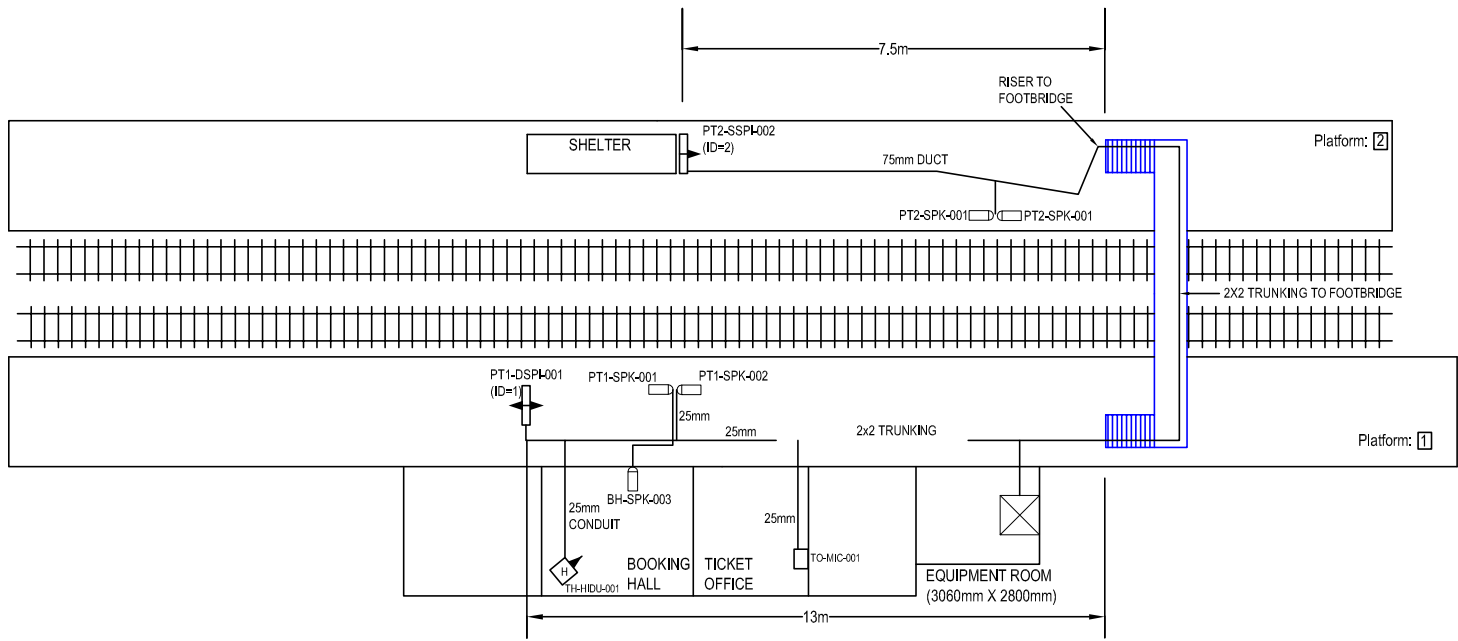

IF IN DOUBT ASK!

MATERIAL	CONSTRUCTION	NAME	SIGNATURE	DATE	 AMEY DATEL Project Offices 1st Floor, Platform 2/3 Eastleigh Station Southampton Road Eastleigh Hants SO50 9FL	SITE/PROJECT			
		DRAWN BY: D GADDU		14-05-01		SOUTH WEST TRAINS CIS PROJECT			
FINISH		CHECKED BY: T WONG			COPYRIGHT © AMEY Rail All rights reserved. Neither this drawing or any of the information it contains may be copied or communicated to third parties without the written permission of the copyright holder	TITLE			
		APPD BY: A SMITH				WORPLESDON AS BUILT			
		CAD Ref:				SCALE	DRG No.	ISSUE	SHEET
		CONTRACTOR'S Ref:				NTS	SM803-75686	C	1 of 1