



WAN	
CIRCUIT ID	KXIP 600421
IP ADDRESS	10.227.222.1

"PLATFORM 1 HP ISDN"
01-929-551624
"PLATFORM 2 HP ISDN"
01-909-551636

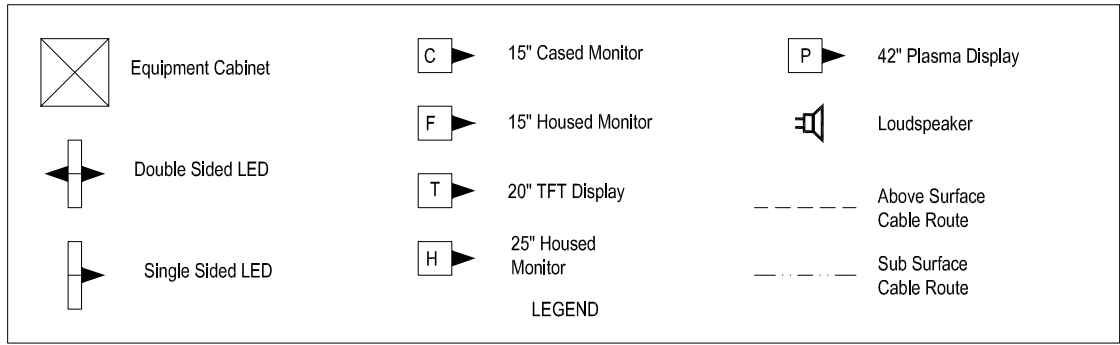

Equipment	Dist Board
CCT 1	13A TWIN
CCT 2	HEATER
CCT 3	CIS CAB
CCT 4	STAT+ FAN

All Equipment tags to be prefixed with "WRM-"

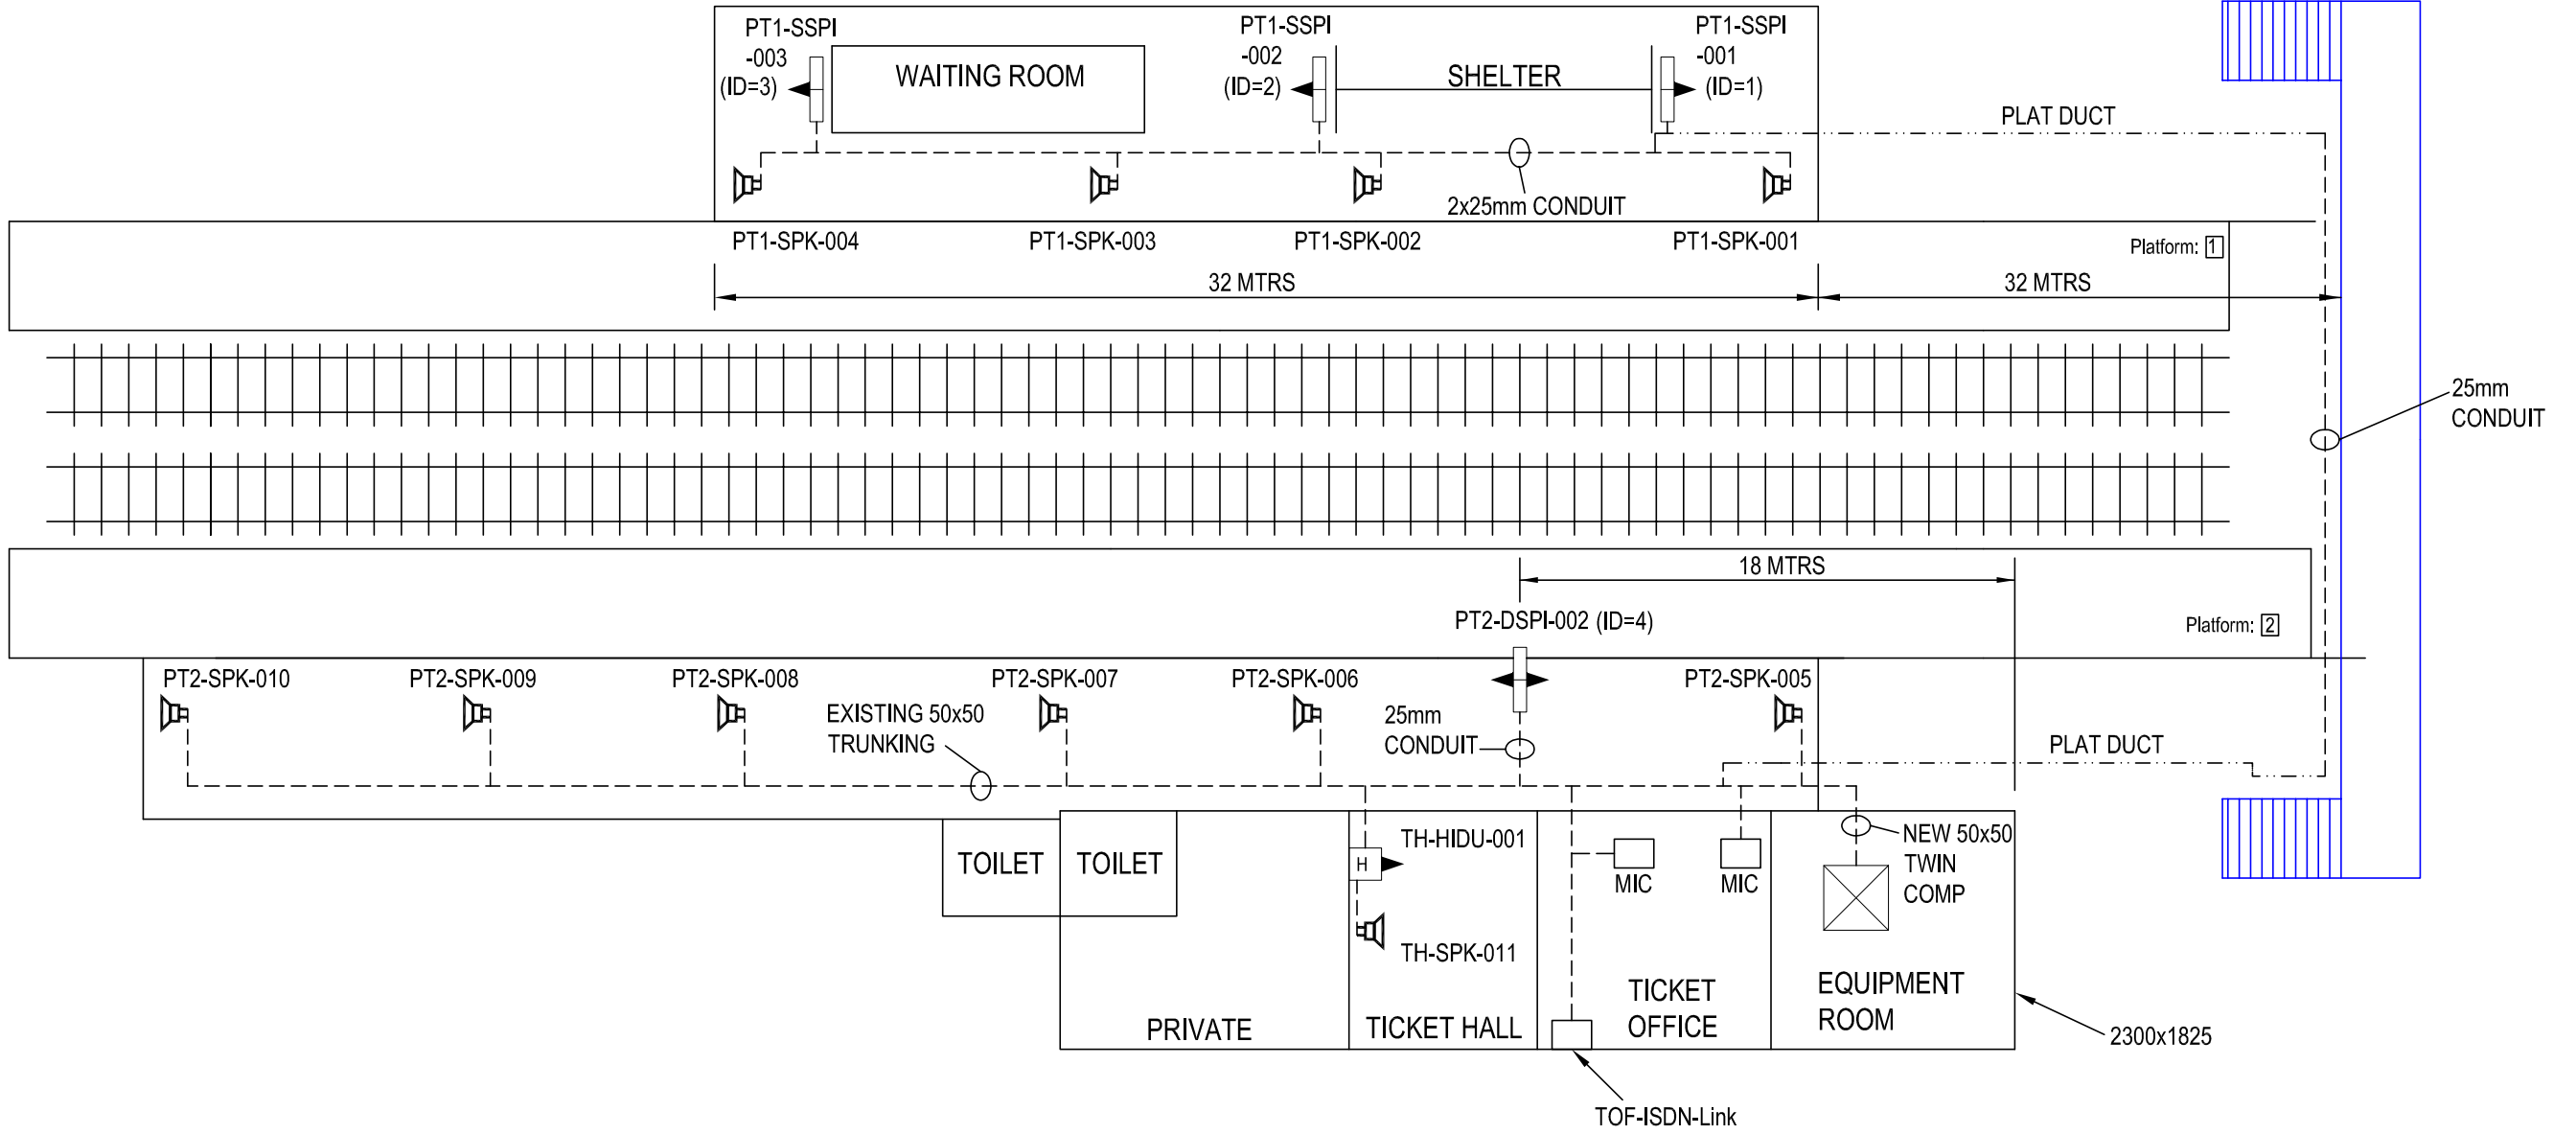

MATERIAL	CONSTRUCTION	IF IN DOUBT ASK!			<p>AMEY DATEL Project Offices 1st Floor, Platform 2/3 Eastleigh Station Southampton Road Eastleigh Hants SO50 9FL</p>	SITE/PROJECT		SOUTH WEST TRAINS CIS PROJECT		
		DRAWN BY	D GADDU	SIGNATURE		DATE	31-01-2002	TITLE		WAREHAM AS BUILT
FINISH		APPD BY				<p>COPYRIGHT © AMEY Rail All rights reserved. Neither this drawing or any of the information it contains may be copied or communicated to third parties without the written permission of the copyright holder</p>	SCALE	DRG No.	ISSUE	SHEET
		CAD Ref:					NTS	SM803-75959	B	1 of 1
		CONTRACTORS Ref:								