



| | |
|------------|--------------|
| WAN | |
| CIRCUIT ID | KXIP900449 |
| IP ADDRESS | 10.227.236.1 |

| |
|----------------------|
| "PLATFORM 1 HP ISDN" |
| 01-784-488036 |
| "PLATFORM 2 HP ISDN" |
| 01-784-488037 |

All Equipment tags to be prefixed with "WRY-"

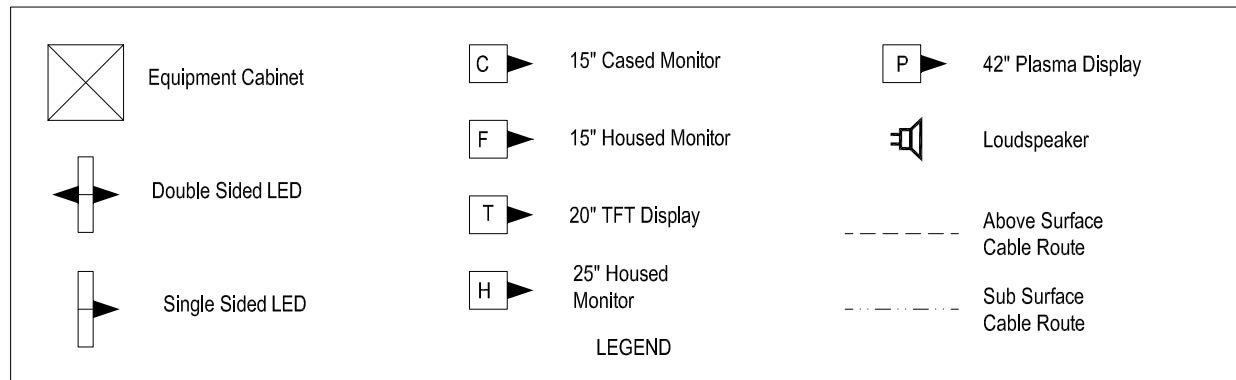

| Equipment | Dist Board | |
|--------------|-------------------------------------|-------|
| CIS RACK | DIST. BOARD IN BOTTOM OF RACK | CCT 6 |
| PT1-DSPI-001 | | CCT 4 |
| PT2-DSPI-002 | | CCT 1 |

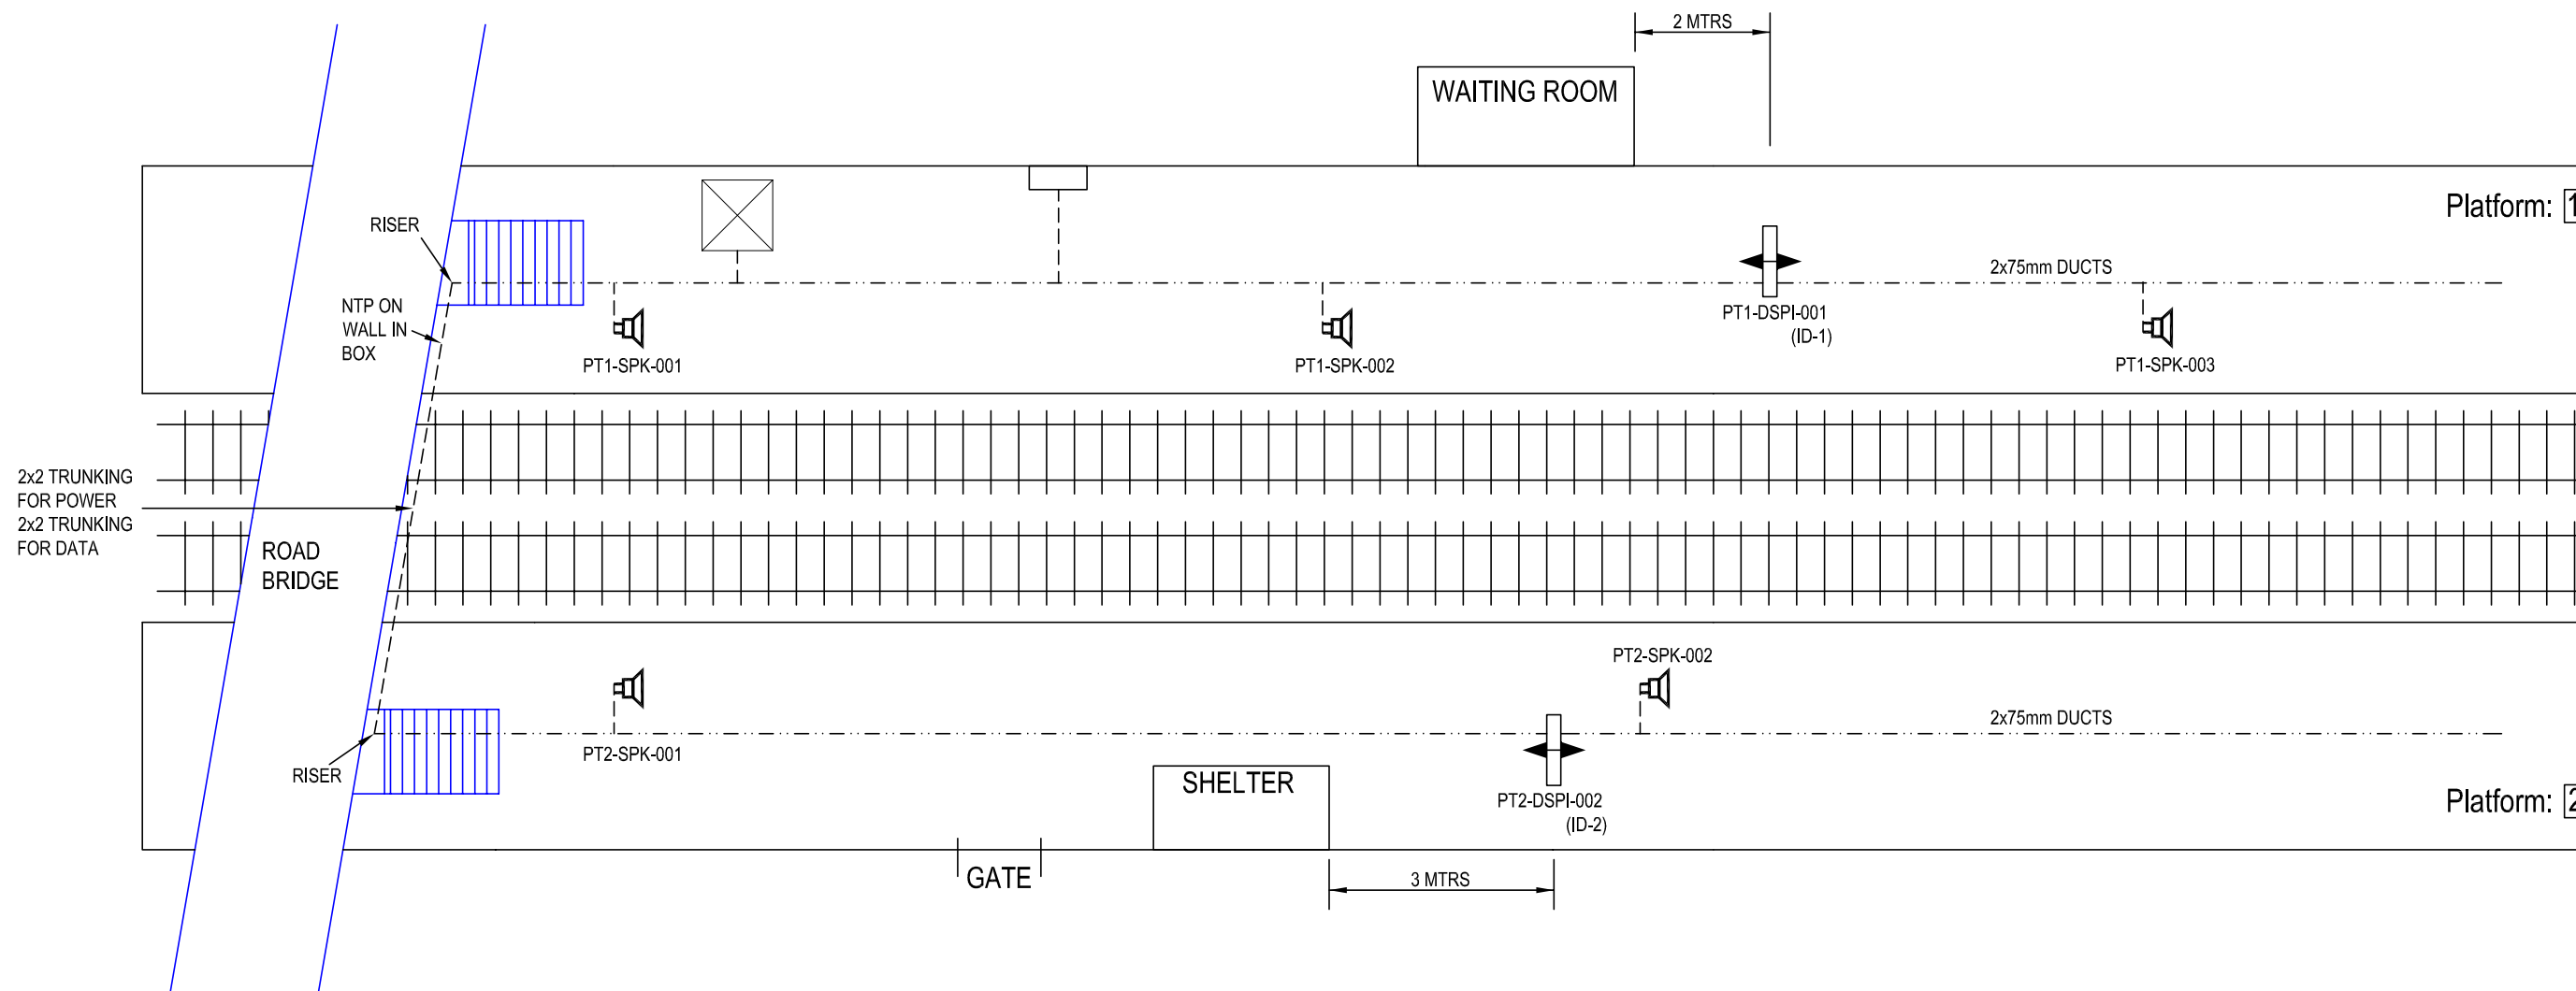

IF IN DOUBT ASK!

| | | | | | | | | | | |
|----------|--------------|-------------------|---------|-----------|----------|---|--------------|-----------------------|-------------------------------|--------|
| MATERIAL | CONSTRUCTION | DRAWN BY | D GADDU | SIGNATURE | | AMEY DATEL Project Offices 1st Floor, Platform 2/3 Eastleigh Station Southampton Road Eastleigh Hants SO50 9FL | SITE/PROJECT | | SOUTH WEST TRAINS CIS PROJECT | |
| | | CHECKED BY | T WONG | DATE | 16-05-01 | | TITLE | WRAYSBURY AS BUILT | | |
| FINISH | | APPD BY | A SMITH | | | | SCALE | DRG No. | ISSUE | SHEET |
| | | CAD Ref: | | | | | NTS | SM803-75673 | B | 1 of 1 |
| | | CONTRACTOR'S Ref: | | | | COPYRIGHT © AMEY Rail All rights reserved. Neither this drawing or any of the information it contains may copied or communicated to third parties without the written permission of the copyright holder | | | | |