



WAN DETAILS	
CIRCUIT ID	KXIP900441
IP ADDRESS	10.227.230.1

"PLATFORM 1 HP ISDN"
01-189-272086
"PLATFORM 2 HP ISDN"
01-189-272108

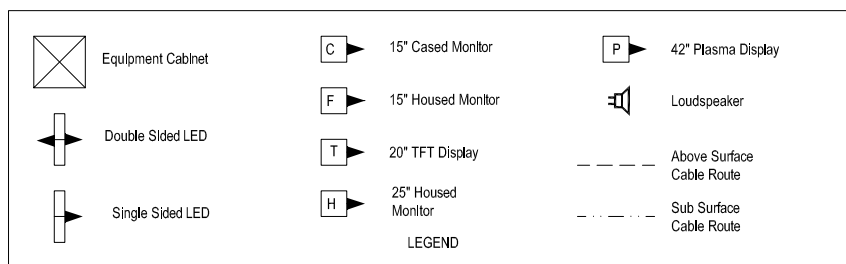

Equipment	Dist Board	
PT1-DSPI-001	GP 2	CCT 8
PT2-DSPI-002	GP 2	CCT 9
BH-FIDU-001	GP 1	CCT 7

All Equipment tags to be prefixed with "WTI-"

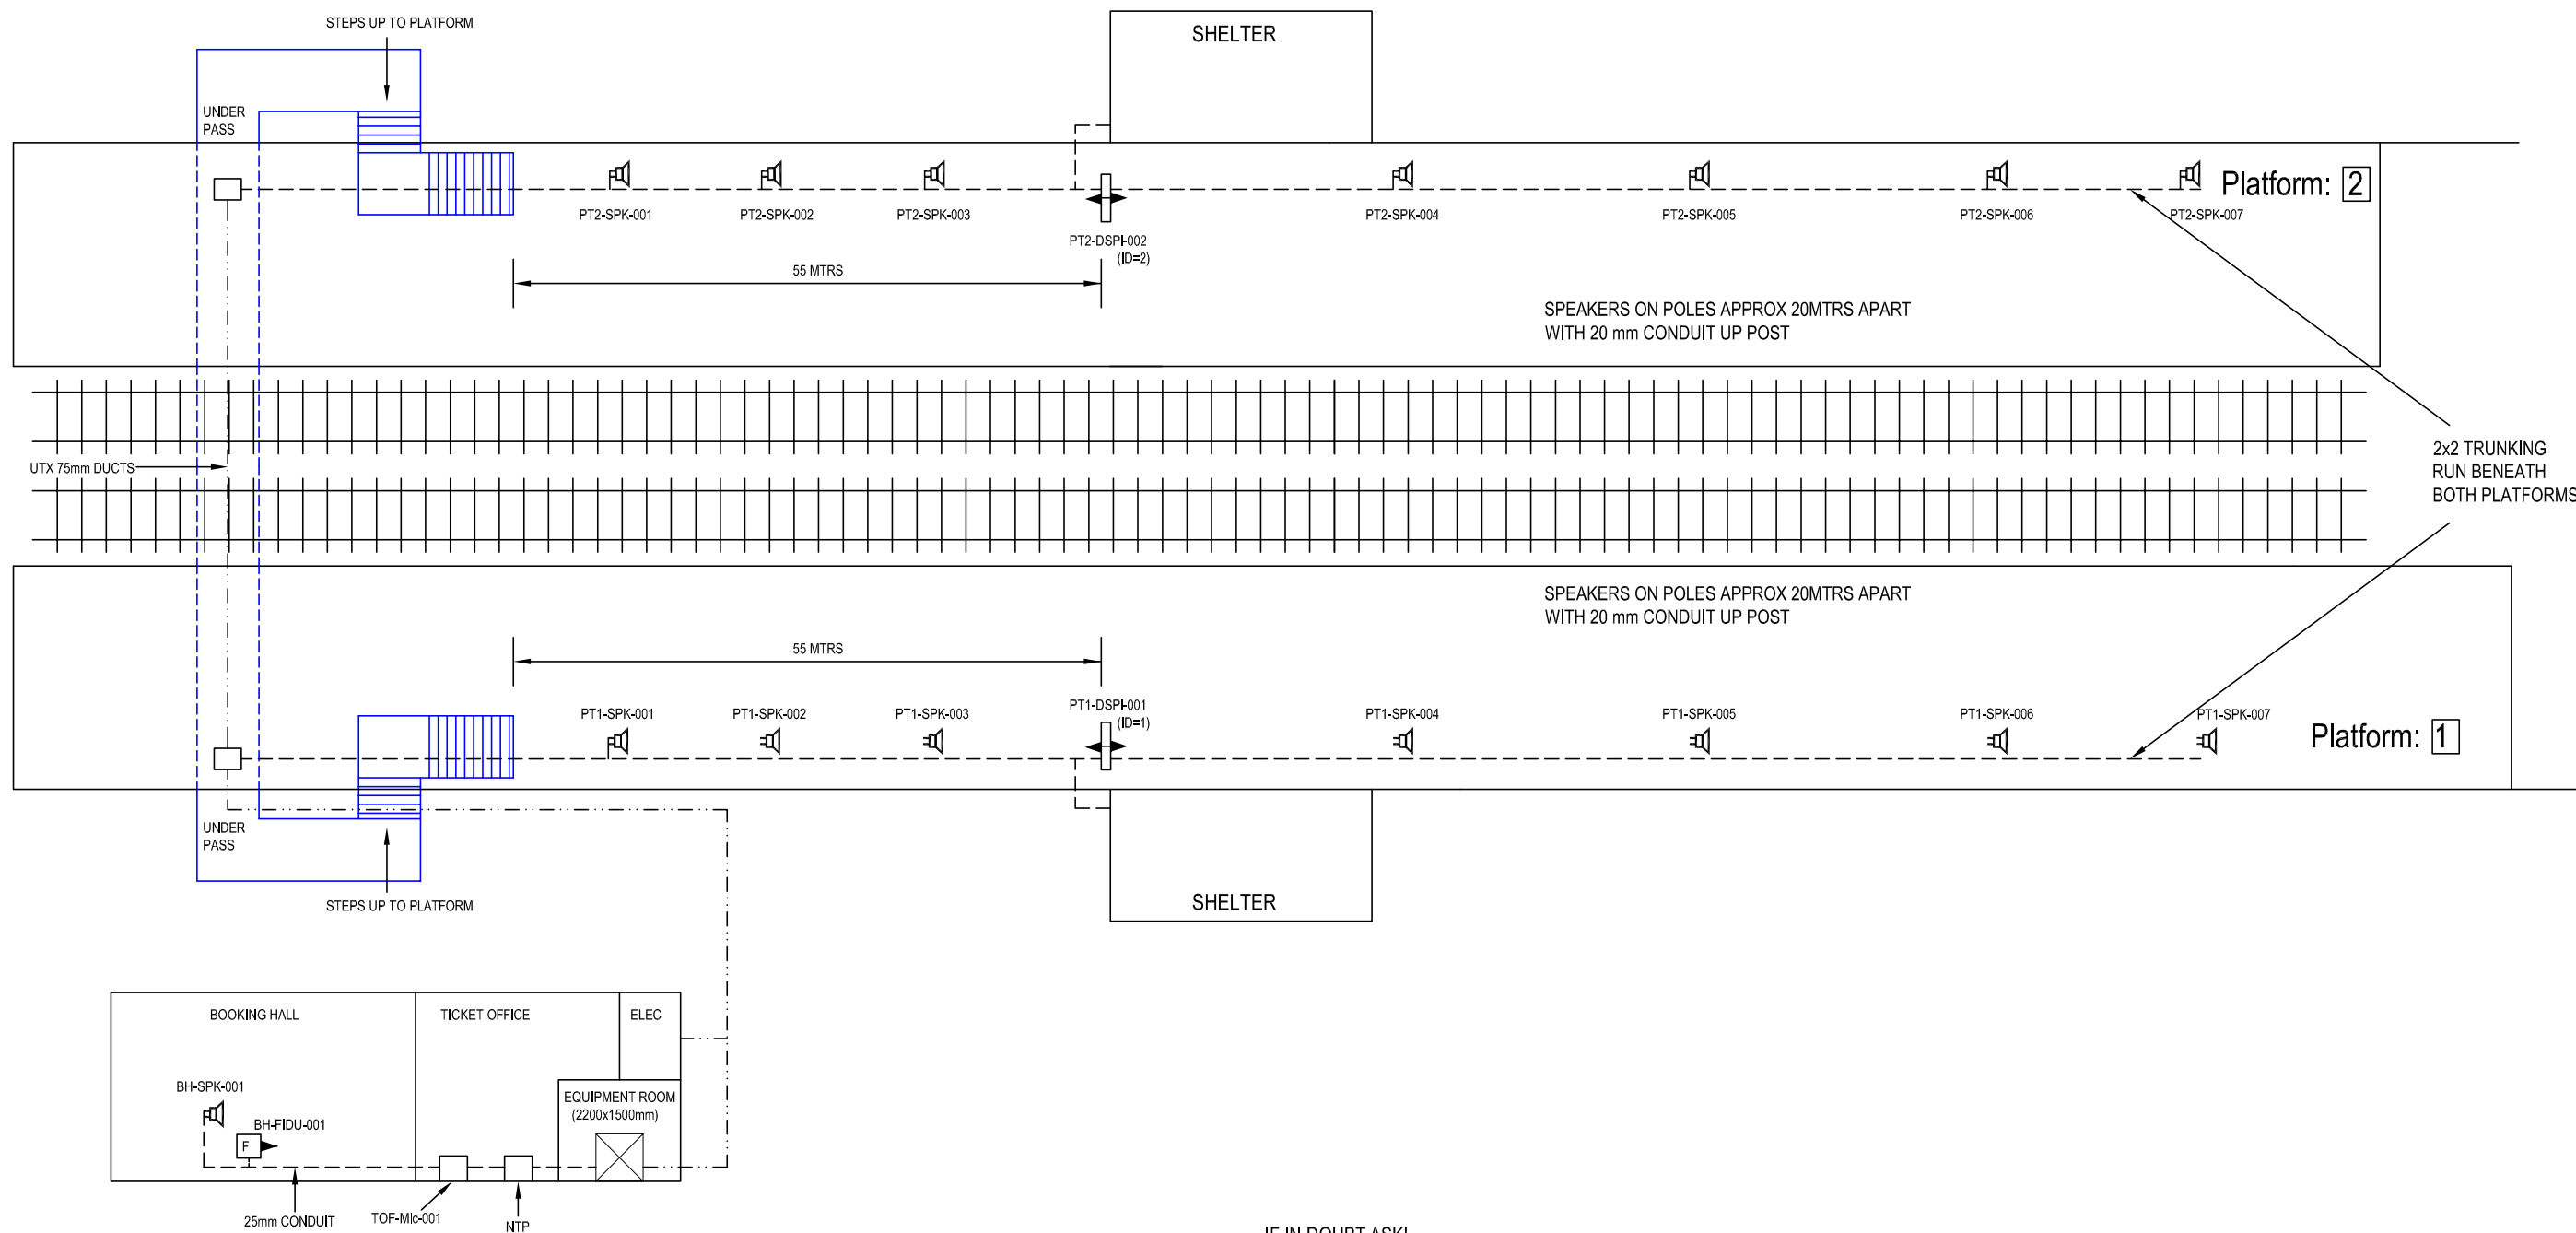

IF IN DOUBT ASK!

MATERIAL	CONSTRUCTION	NAME	SIGNATURE	DATE	<p>AMEY DATEL Project Offices 1st Floor, Platform 2/3 Eastleigh Station Southampton Road Eastleigh Hants SO50 9FL</p>	SITE/PROJECT		
		DRAWN BY	D GADDU	25-05-01		SOUTH WEST TRAINS CIS PROJECT		
		CHECKED BY	T WONG			TITLE		
		APPD BY	A SMITH			WINNERSH TRIANGLE AS BUILT		
		APPD BY				SCALE	DRG No.	
FINISH		CAD Ref:			NTS	SM803-75698	ISSUE	SHEET
		CONTRACTOR'S Ref:					B	1 of 1

COPYRIGHT © AMEY Rail
All rights reserved. Neither this drawing or any of the information it contains may be copied or communicated to third parties without the written permission of the copyright holder