

WAN	
CIRCUIT ID	KXIP300435
IP ADDRESS	10.227.227.1


"PLATFORM 1 HP ISDN"
020-8893-3266
"PLATFORM 2 HP ISDN"
020-8893-4337

	Equipment Cabinet		15" Cased Monitor		Loudspeaker
	Double Sided LED		15" Housed Monitor		Above Surface Cable Route
	Single Sided LED		20" TFT Display		Sub Surface Cable Route
			25" Housed Monitor		Radio Microphone Antenna
			42" Plasma Display		Radio Microphone Base Unit

LEGEND

Equipment	Dist Board
CIS RACK	NEW BOARD
ALL OTHERS EXISTING SPURS USED	

All Equipment tags to be prefixed with "WTN-"

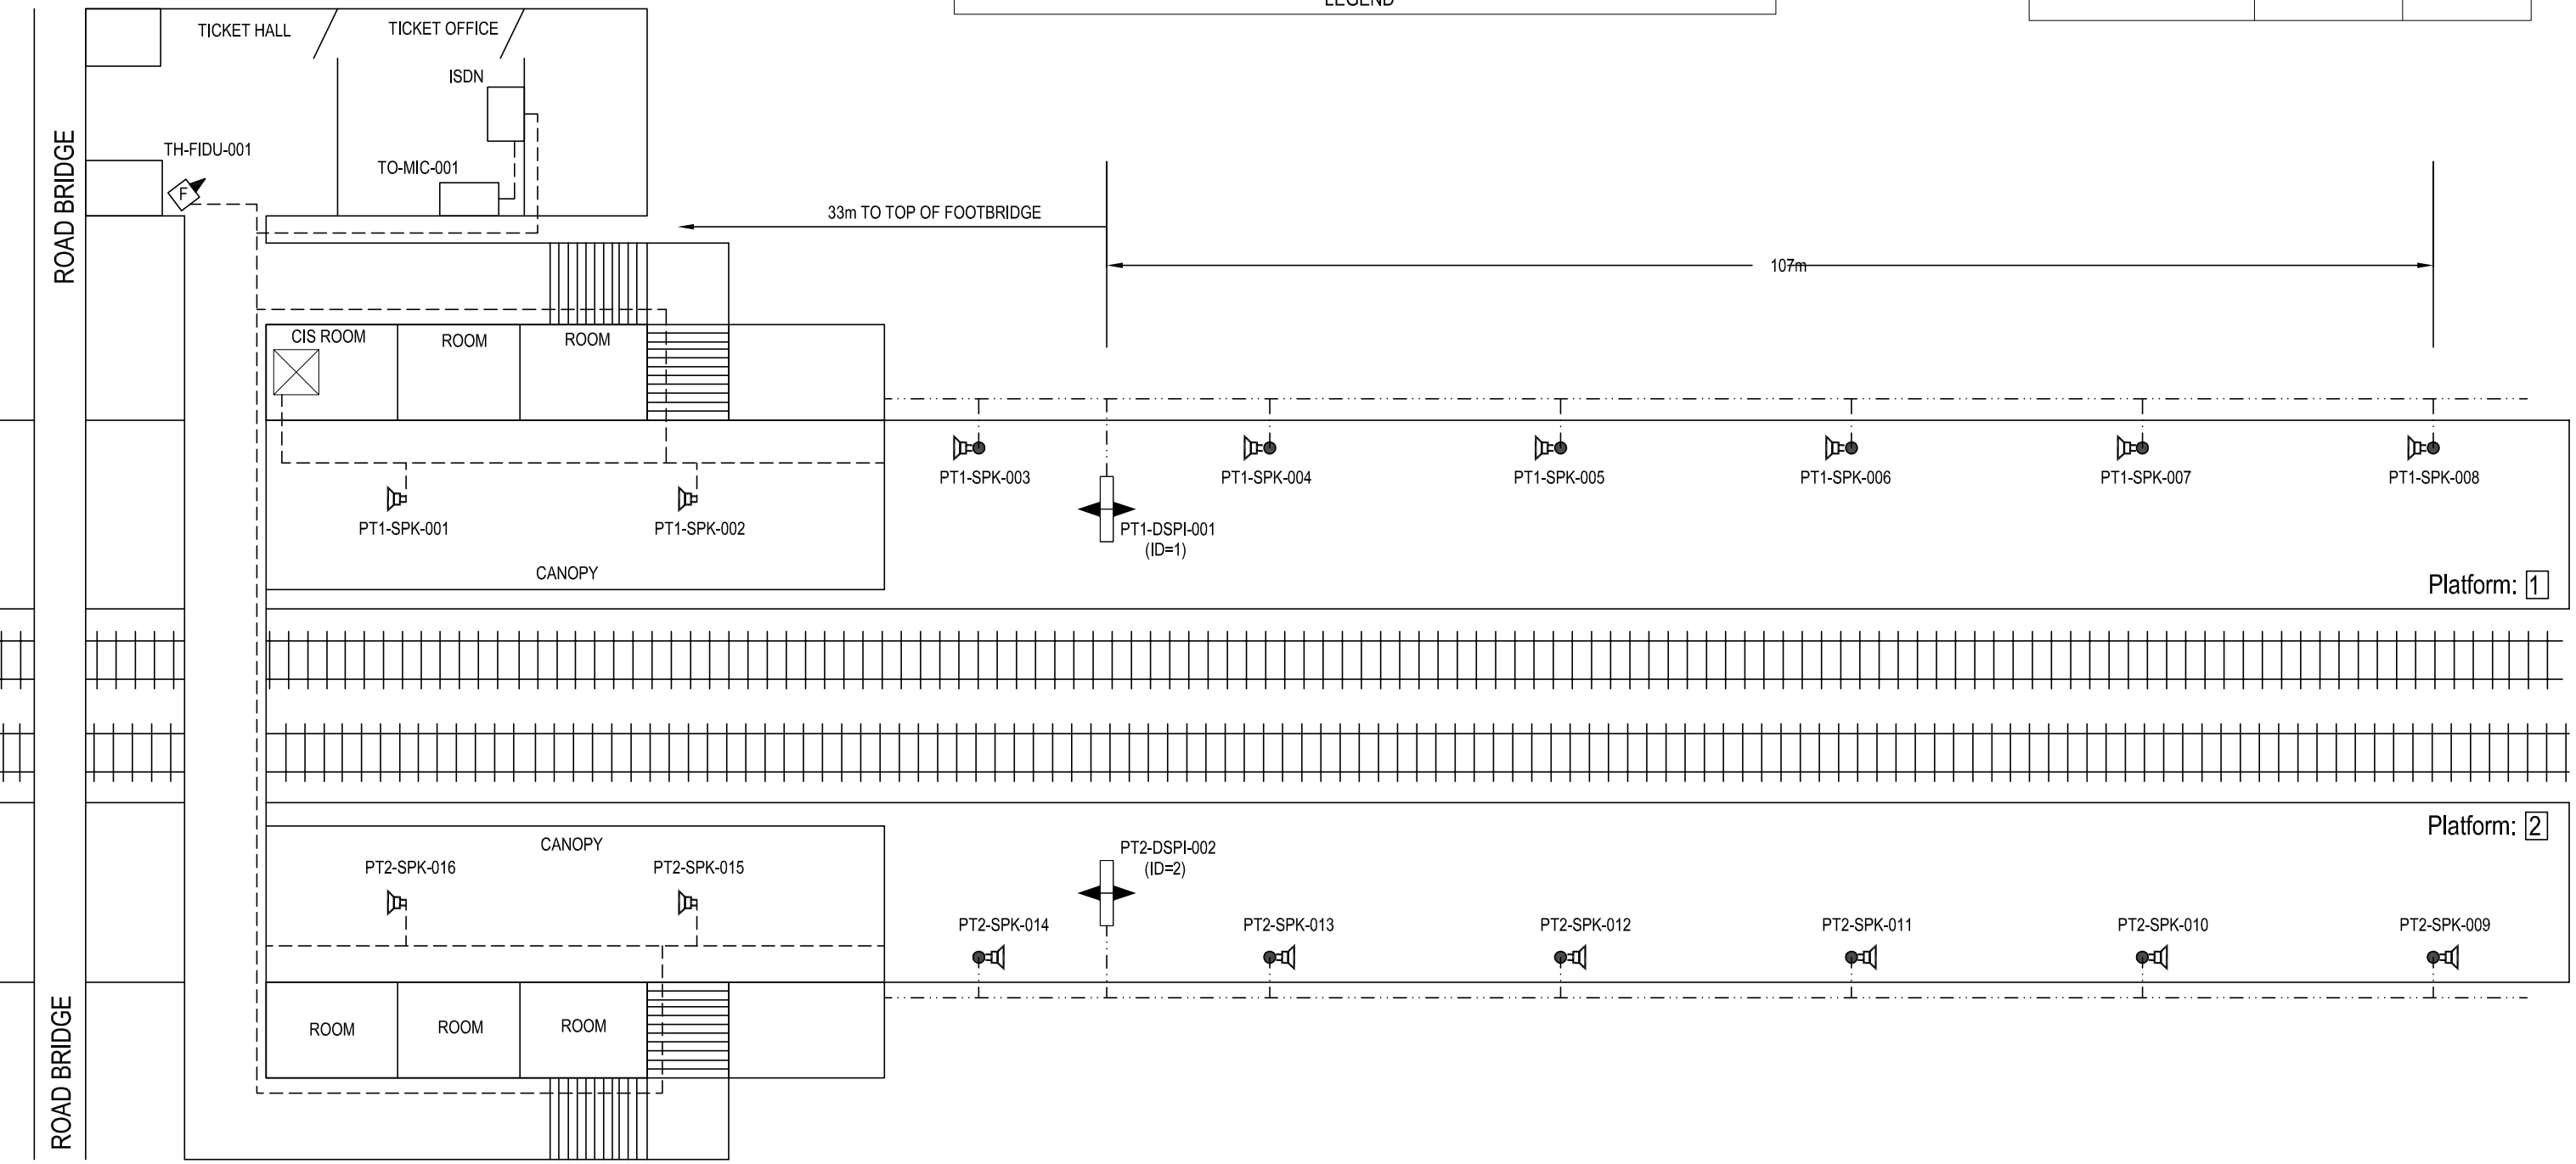

IF IN DOUBT ASK!

MATERIAL	CONSTRUCTION	DRAWN BY	A HATTON	SIGNATURE	DATE	<p>AMEY DATEL Project Offices 1st Floor, Platform 2/3 Eastleigh Station Southampton Road Eastleigh Hants SO50 9FL</p>	SITE/PROJECT		SOUTH WEST TRAINS CIS PROJECT	
		CHECKED BY	T WONG				TITLE	WHITTON AS BUILT		
FINISH		APPD BY	A SMITH			<p>COPYRIGHT © AMEY Rail All rights reserved. Neither this drawing or any of the information it contains may be copied or communicated to third parties without the written permission of the copyright holder</p>	SCALE	DRG No.	ISSUE	SHEET
		CAD Ref:					NTS	SM803-75611	B	1 of 1
		CONTRACTOR'S Ref:								