



WAN	
CIRCUIT ID	KXIP 900443
IP ADDRESS	10.227.231.1

"PLATFORM 1 HP ISDN"
01428-685561
"PLATFORM 2 HP ISDN"
01428-685638

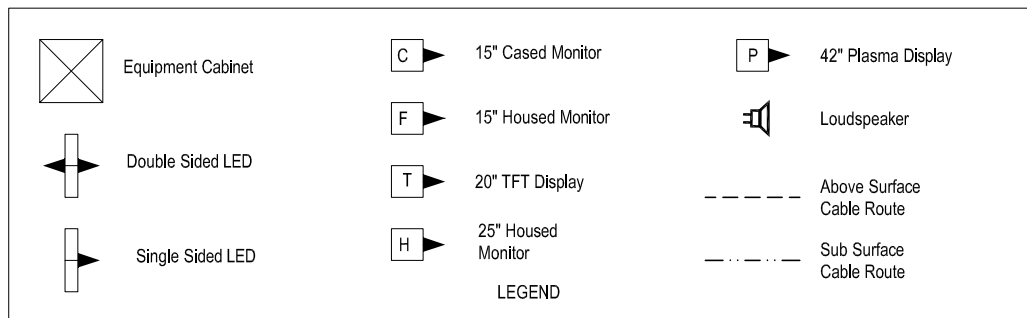

Equipment	Dist Board	
CIS RACK	GP1 CCT3 TO 6 WAY	C40A
PT1-SSPI-001	CRABTREE POLESTAR CCT2	C16A
PT1-SSPI-002	GP1 CCT8	C16A
TH-HIDU-001	POLESTAR CCT6	C16A
PT2-DSPI-003	POLESTAR CCT5	C16A

All Equipment tags to be prefixed with "WTY-"

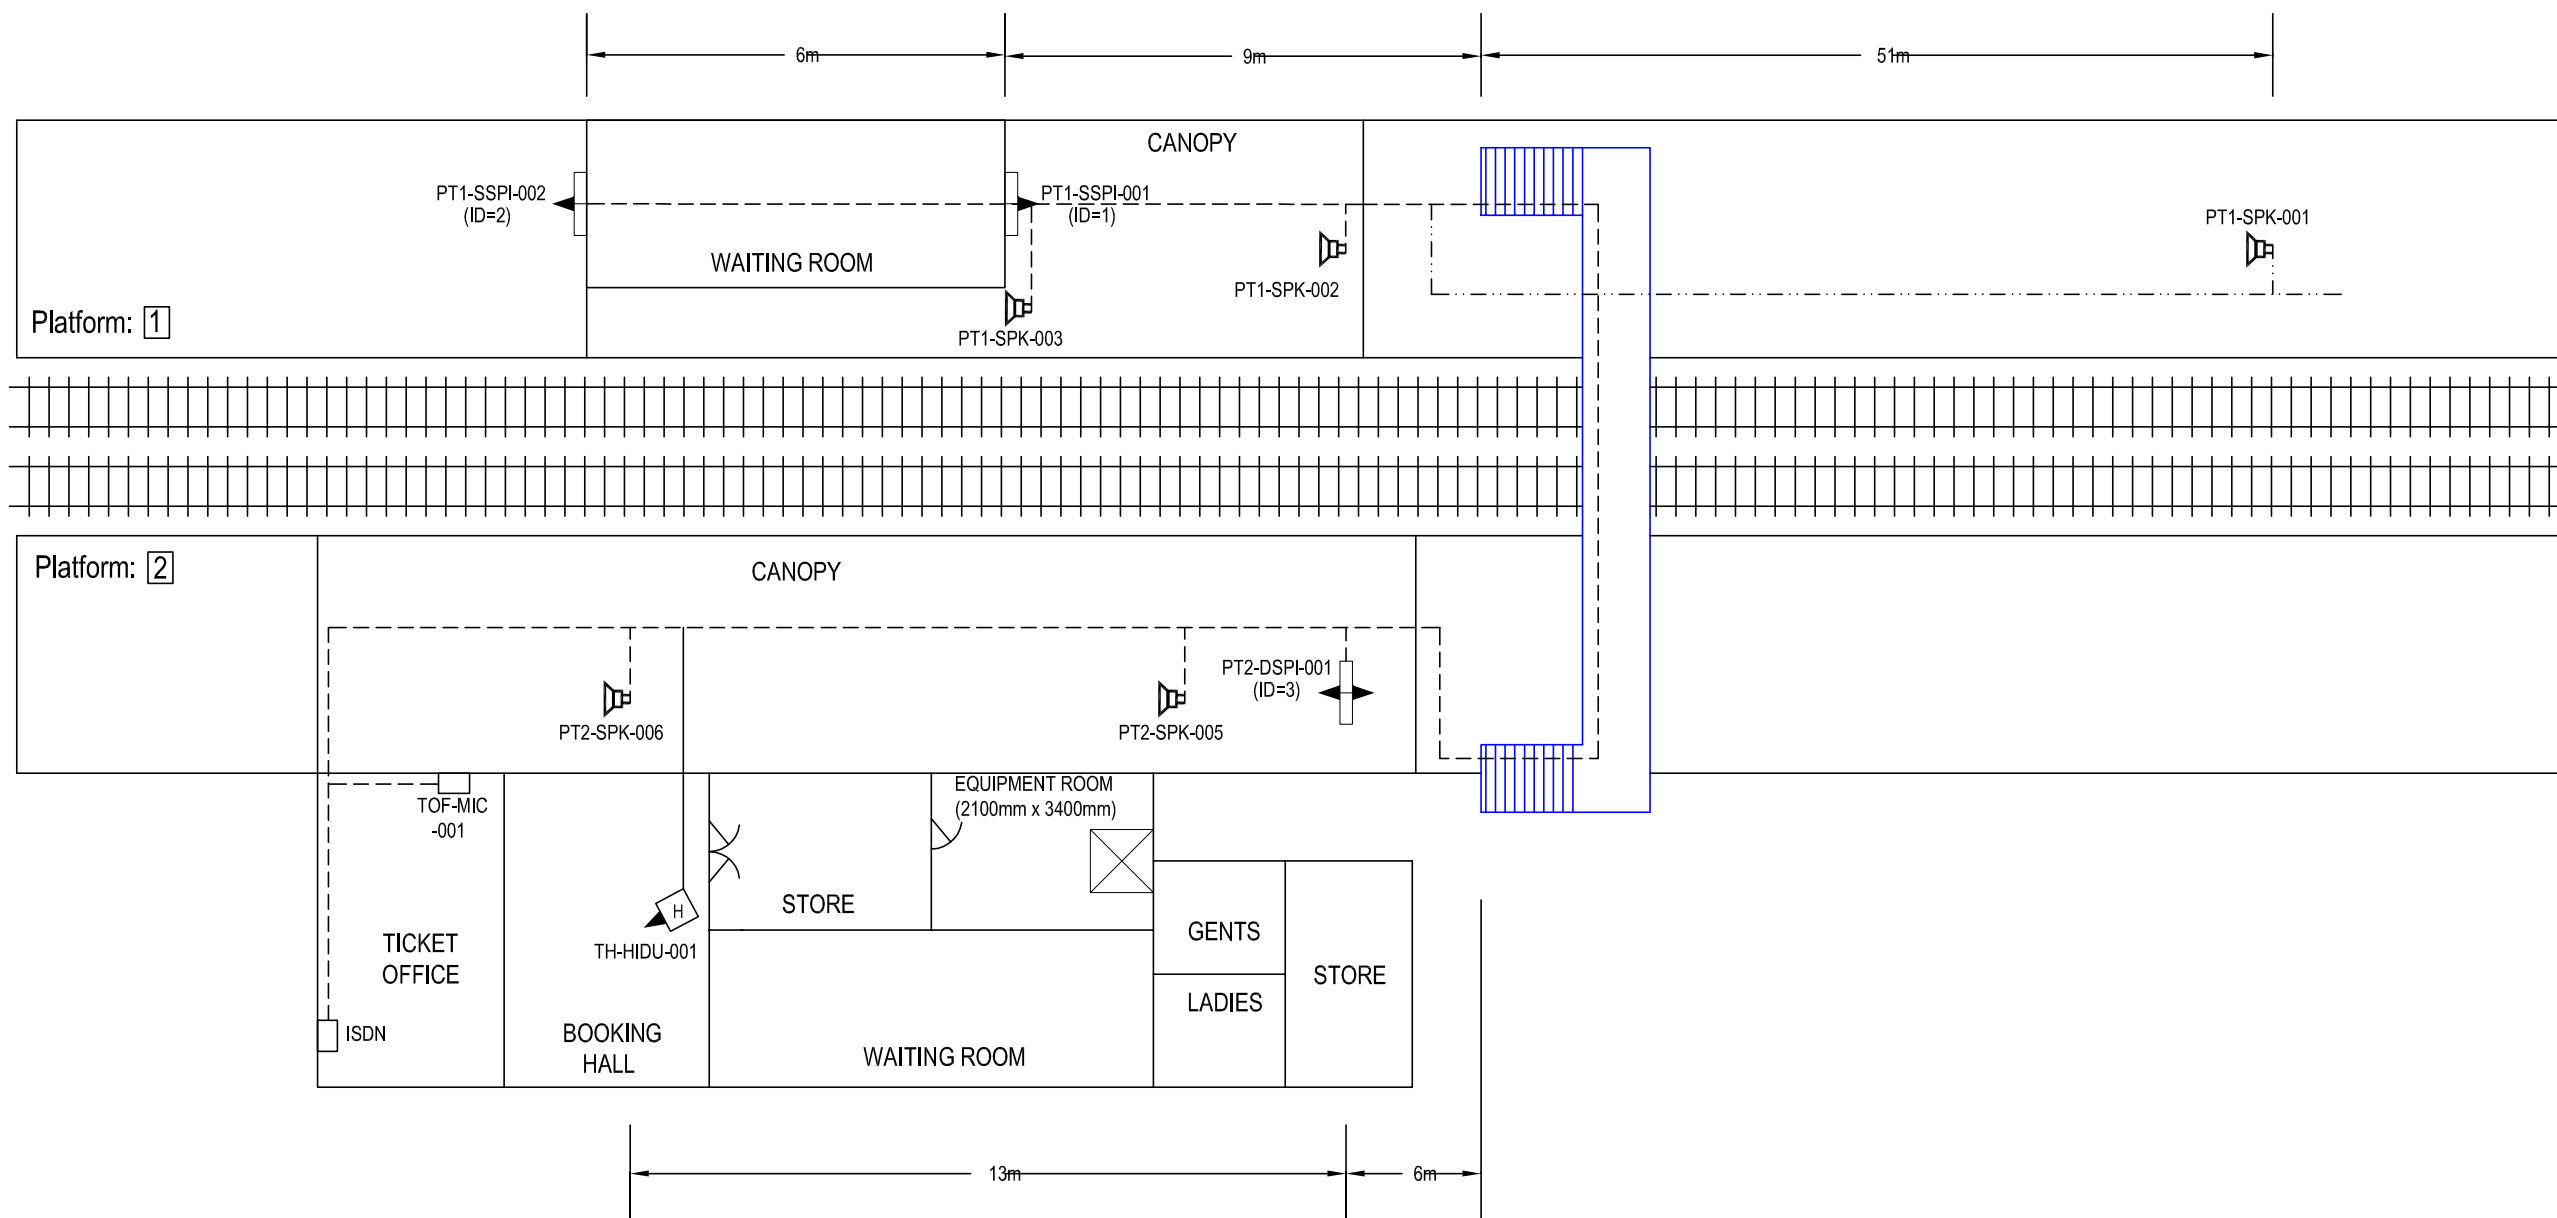

IF IN DOUBT ASK!

Date of Last Modification: 25 April 2003	CONSTRUCTION	NAME	SIGNATURE	DATE	AMEY DATEL Project Offices 1st Floor, Platform 2/3 Eastleigh Station Southampton Road Eastleigh Hants SO50 9FL	SITE/PROJECT SOUTH WEST TRAINS CIS PROJECT
		DRAWN BY	J STEVENS	25-04-2003		
This Drawing Supersedes Any Previous Drawings	FINISH	CHECKED BY	T WONG		COPYRIGHT © AMEY Rail All rights reserved. Neither this drawing or any of the information it contains may be copied or communicated to third parties without the written permission of the copyright holder	TITLE WITLEY AS BUILT
		APPD BY	A SMITH			
		CAD Ref:			SCALE NTS	DRG No. SM803-75640
		CONTRACTOR'S Ref:				ISSUE C
						SHEET 1 of 1