

DRG No.


SM803-75932

WAN	
CIRCUIT ID	KXIP500412
IP ADDRESS	10.227.68.1


"PLATFORM 1 HP ISDN"
01-935-471636

All Equipment tags to be prefixed with "YVJ-"


NOTE: VDA Unit is feeding 2 monitors, TH-CIDU-002 and TO-CIDU-003.

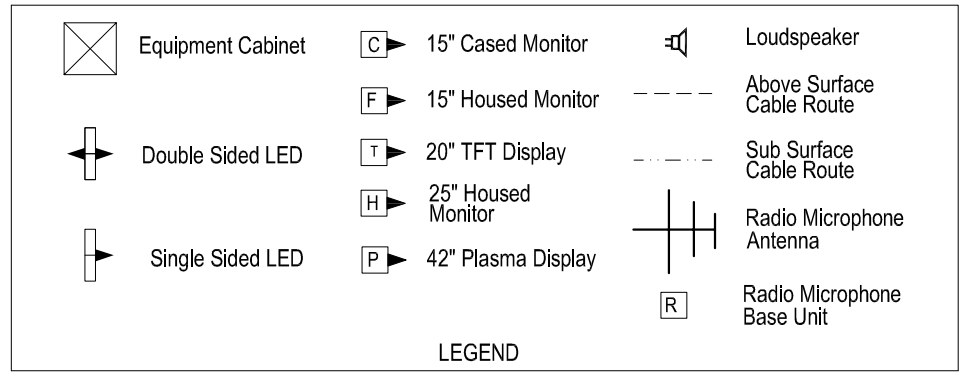

Equipment	Dist Board
EXISTING SPURS USED	

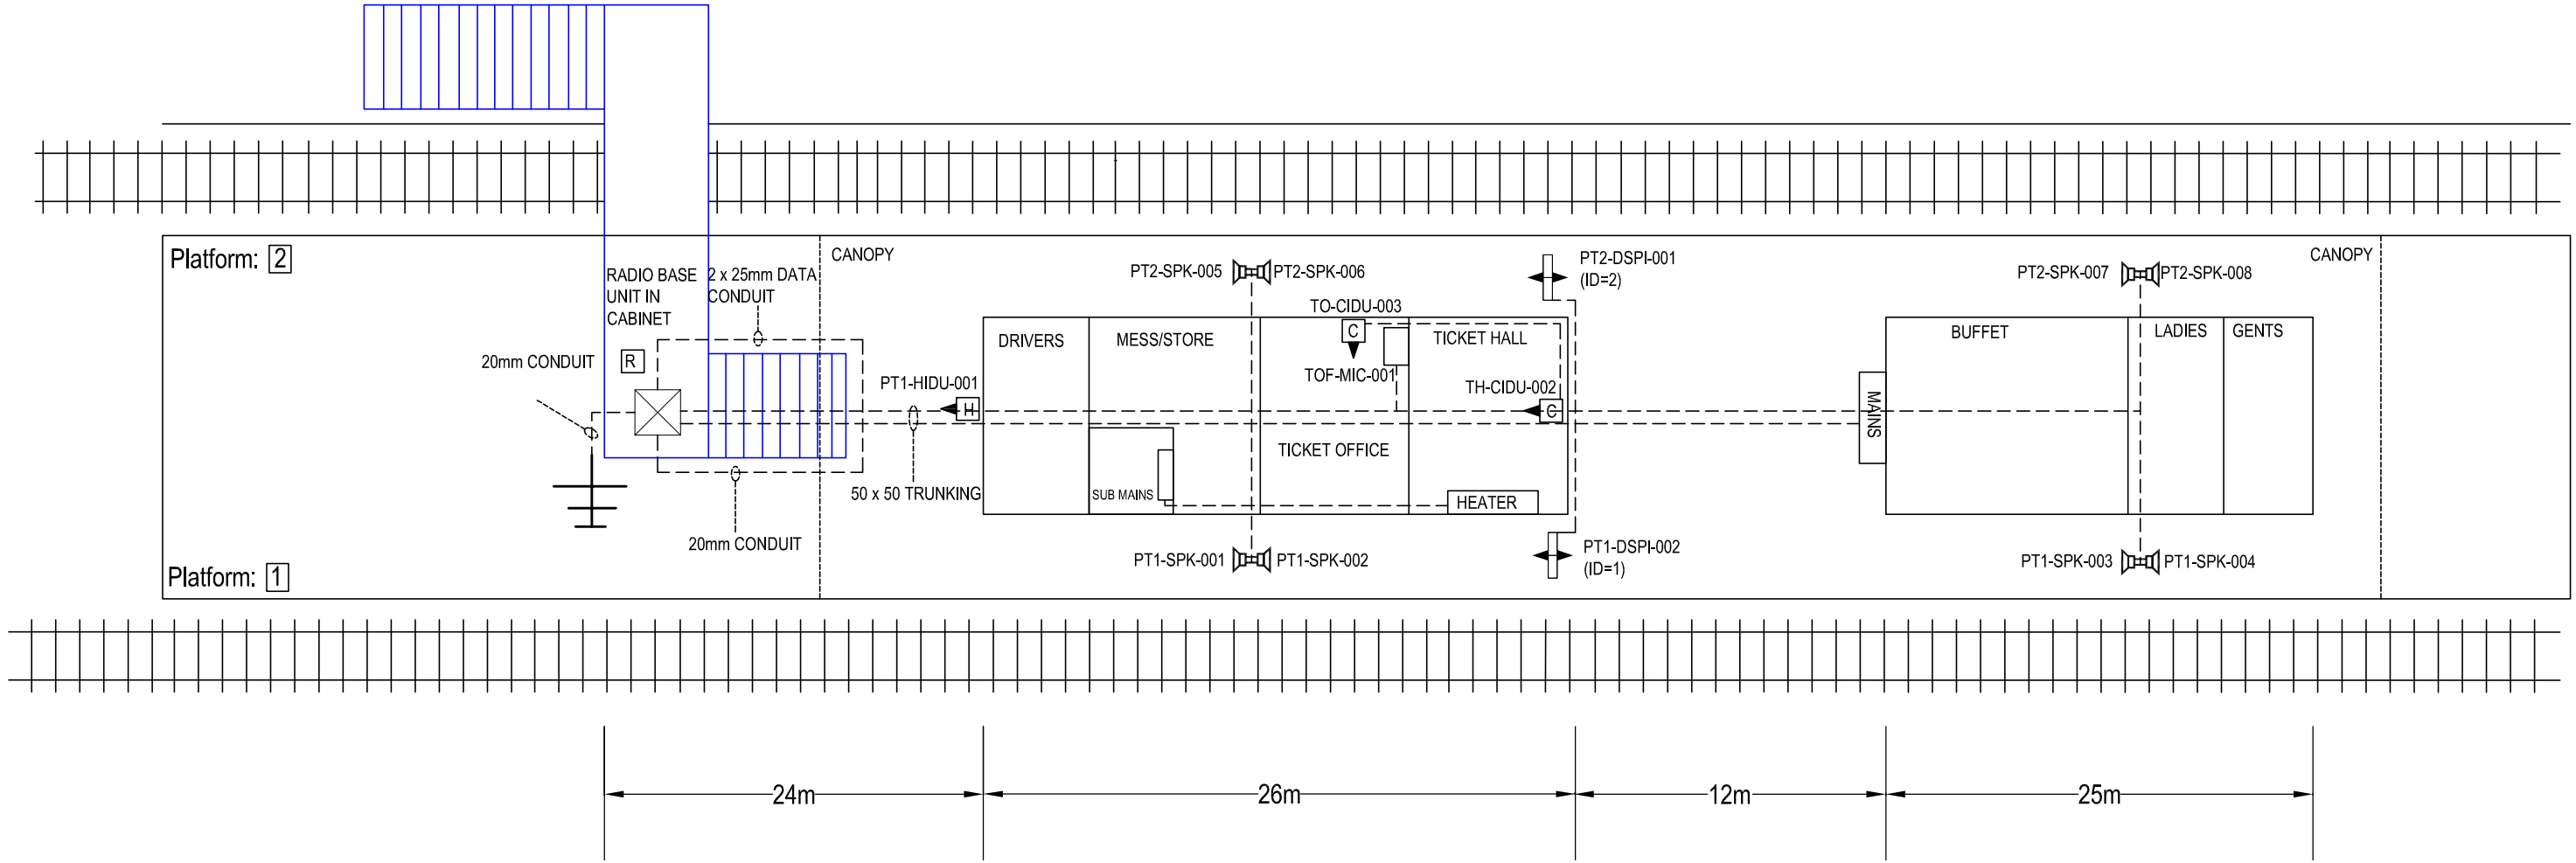

IF IN DOUBT ASK!

MATERIAL	CONSTRUCTION	NAME	SIGNATURE	DATE	 <p>AMEY DATEL Project Offices 1st Floor, Platform 2/3 Eastleigh Station Southampton Road Eastleigh Hants SO50 9FL</p>	SITE/PROJECT		
		DRAWN BY	A HATTON	07-05-2002		SOUTH WEST TRAINS CIS PROJECT		
FINISH	CONSTRUCTION	CHECKED BY	T WONG		<p>COPYRIGHT © AMEY Rail All rights reserved. Neither this drawing or any of the information it contains may be copied or communicated to third parties without the written permission of the copyright holder</p>	TITLE		
		APPD BY	A SMITH			YEOVIL JUNCTION AS BUILT		
		CAD Ref:			SCALE	DRG No.	ISSUE	SHEET
		CONTRACTOR'S Ref:			NTS	SM803-75932	C	1 of 1