DRG No.

SM803-75624

WAN	
CIRCUIT ID	KXIP900432
IP ADDRESS	10.227.85.1

HPT ISDN
01-420-520205

All Equipment tags to be prefixed with "BTY-"

Equipment Cabinet
Double Sided LED
Single Sided LED
C 15" Cased Monitor
F 15" Housed Monitor
T 20" TFT Display
H 25" Housed Monitor
P 42" Plasma Display
Loudspeaker
Above Surface Cable Route
Sub Surface Cable Route
Radio Microphone Antenna
R Radio Microphone Base Unit

LEGEND

Equipment	Dist Board	
CIS RACK	LOCAL BOARD NOT MARKED	

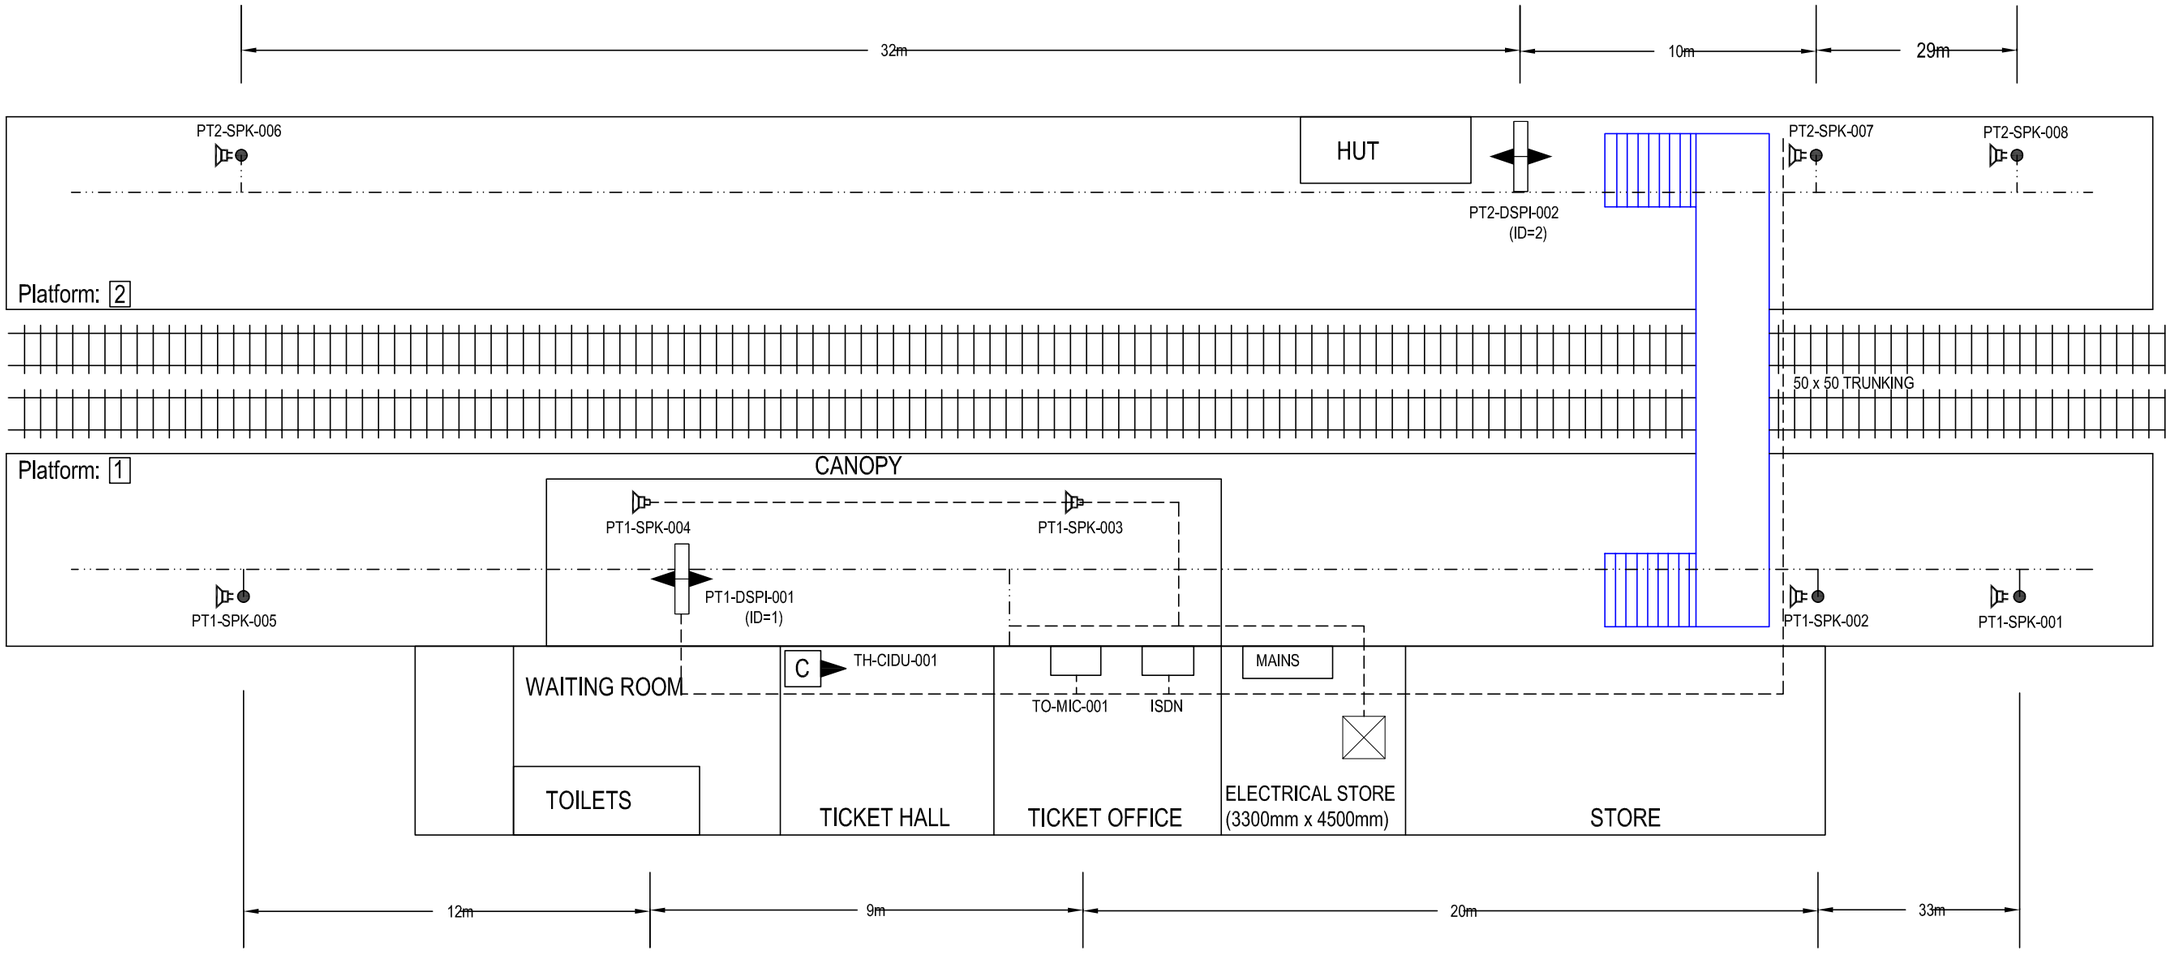

IF IN DOUBT ASK!

MATERIAL	CONSTRUCTION		NAME	SIGNATURE	DATE
		DRAWN BY	D GADDU		21-05-2002
FINISH		CHECKED BY	T WONG		
		APPD BY	A SMITH		
		APPD BY			
		CAD Ref:			
		CONTRACTOR'S Ref:			

AMEY DATEL Project
Offices
1st Floor, Platform
2/3
Eastleigh Station
Southampton Road
Eastleigh
Hants
SO50 9FL

COPYRIGHT © AMEY Rail
All rights reserved. Neither this drawing or any of the information it contains may copied or communicated to third parties without the written permission of the copyright holder

SITE/PROJECT: SOUTH WEST TRAINS CIS PROJECT

TITLE: BENTLEY AS BUILT

SCALE	DRG No.	ISSUE	SHEET
NTS	SM803-75624	B	1 of 1