DRG No.

SM803-75832

WAN	
CIRCUIT ID	KXIP 300412
IP ADDRESS	10.227.136.1

"PLATFORM 1 HP ISDN"
01460-72150

All Equipment tags to be prefixed with "CKN-"

Equipment Cabinet
Double Sided LED
Single Sided LED
C 15" Cased Monitor
F 15" Housed Monitor
T 20" TFT Display
H 25" Housed Monitor
P 42" Plasma Display
Loudspeaker
Above Surface Cable Route
Sub Surface Cable Route

LEGEND

EQUIPMENT	DIST BOARD	
HEATER	CCT NO. 1	
TWIN 13 AMP	CCT NO .2	
CIS RACK	CCT NO. 3	
STAT + FAN	CCT NO. 4	
LIGHT	CCT NO. 5	
CRT TICKET HALL	CCT NO. 6	
LED PT 1	CCT NO. 7	
SPARE	CCT NO. 8/9	

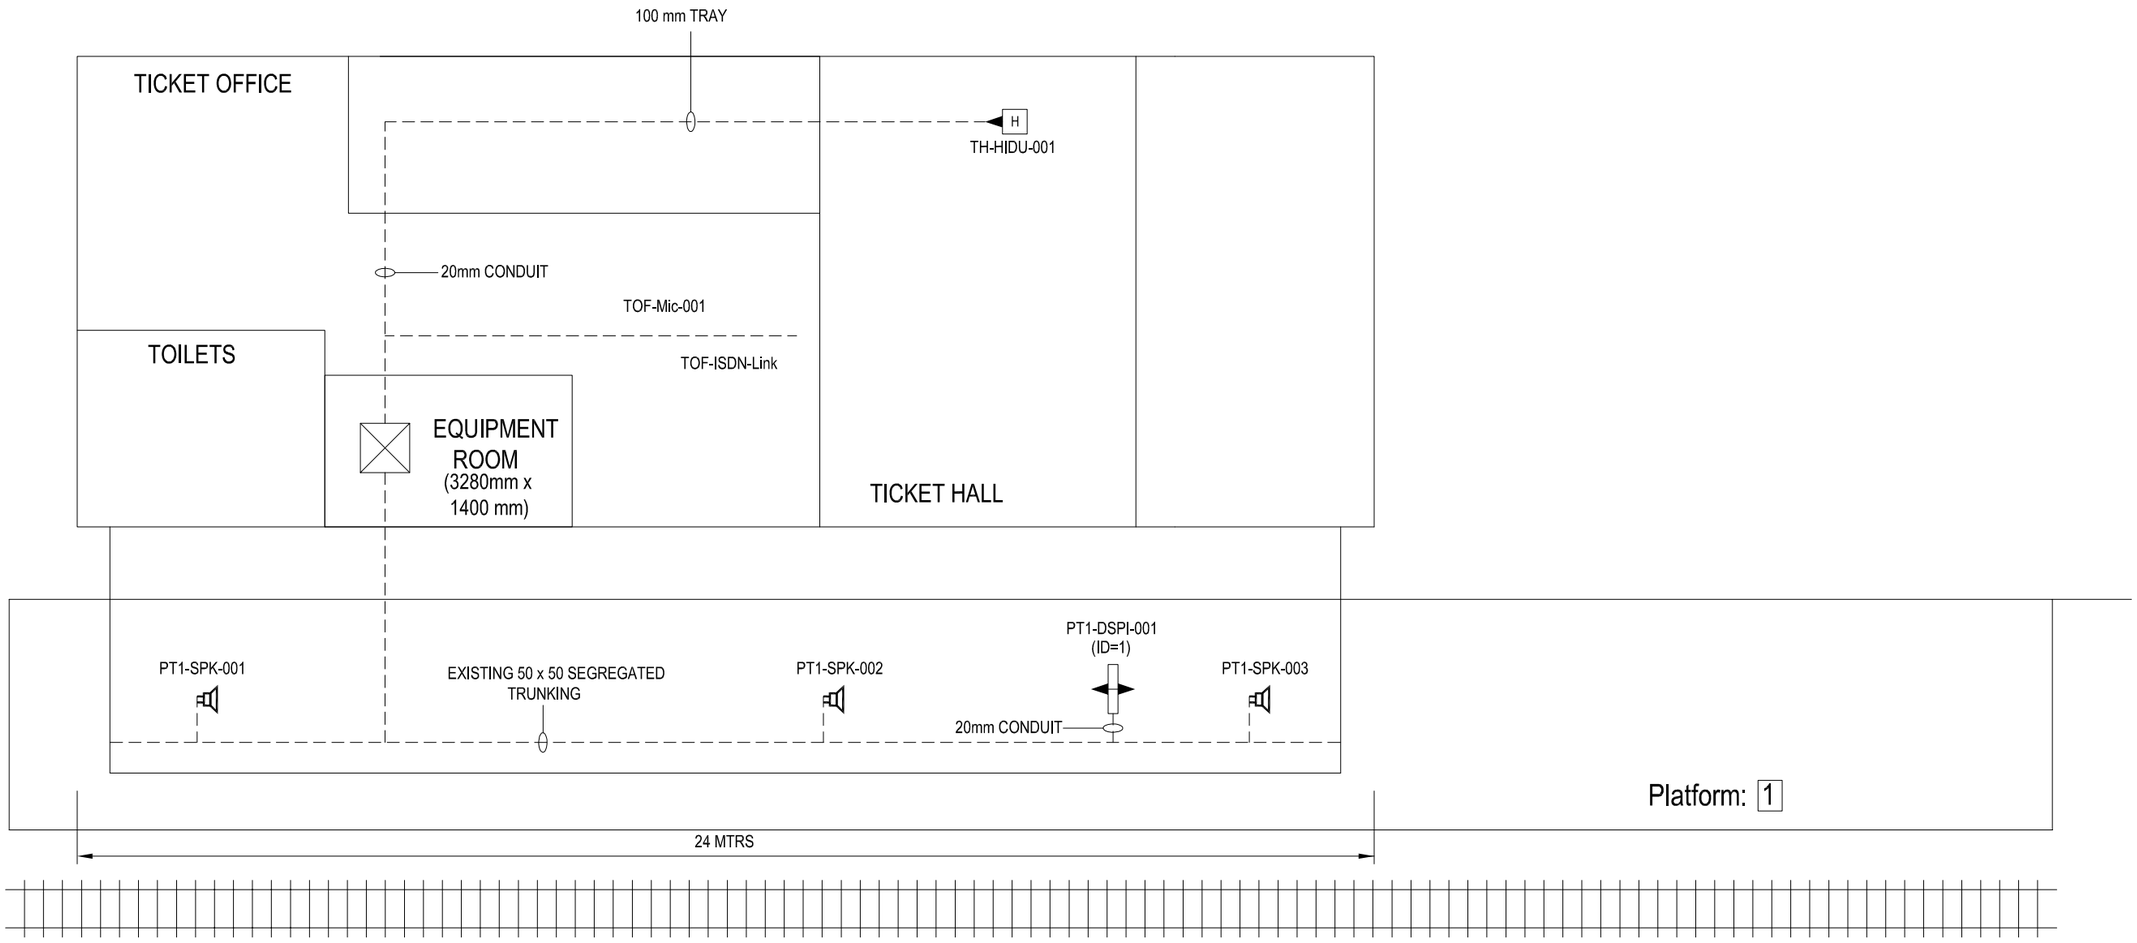

IF IN DOUBT ASK!

MATERIAL

FINISH

CONSTRUCTION

	NAME	SIGNATURE	DATE
DRAWN BY	D GADDU		15-03-2002
CHECKED BY	T WONG		
APPD BY			
APPD BY			

CAD Ref:

CONTRACTOR'S Ref:

AMEY DATEL Project Offices
1st Floor, Platform 2/3
Eastleigh Station
Southampton Road
Eastleigh
Hants
SO50 9FL

COPYRIGHT © AMEY Rail
All rights reserved. Neither this drawing or any of the information it contains may copied or communicated to third parties without the written permission of the copyright holder

SITE/PROJECT: SOUTH WEST TRAINS CIS PROJECT

TITLE: CREWKERNE AS BUILT

SCALE	DRG No.	ISSUE	SHEET
NTS	SM803-75832	B	1 of 1