DRG No.
SM803-75885

WAN	
CIRCUIT ID	KXIP 600375
IP ADDRESS	10.227.191.1

"PLATFORM 1 HP ISDN"
01202 434967
"PLATFORM 2 HP ISDN"
01202 434905

All Equipment tags to be prefixed with "POK-"

Equipment Cabinet
Double Sided LED
Single Sided LED
C 15" Cased Monitor
F 15" Housed Monitor
T 20" TFT Display
H 25" Housed Monitor
P 42" Plasma Display
Loudspeaker
Above Surface Cable Route
Sub Surface Cable Route
LEGEND

Equipment	Dist Board	
CCT NO 1	HEATER	
CCT NO 2	CIS UNIT	
CCT NO 3	13 AMP TWIN ?	
CCT NO 4	IDU 001	
CCT NO 5	LED PLAT 1	
CCT NO 6	LED PLAT 2	
CCT NO 7	SPARE	
CCT NO 8	SPARE	
CCT NO 9	SPARE	

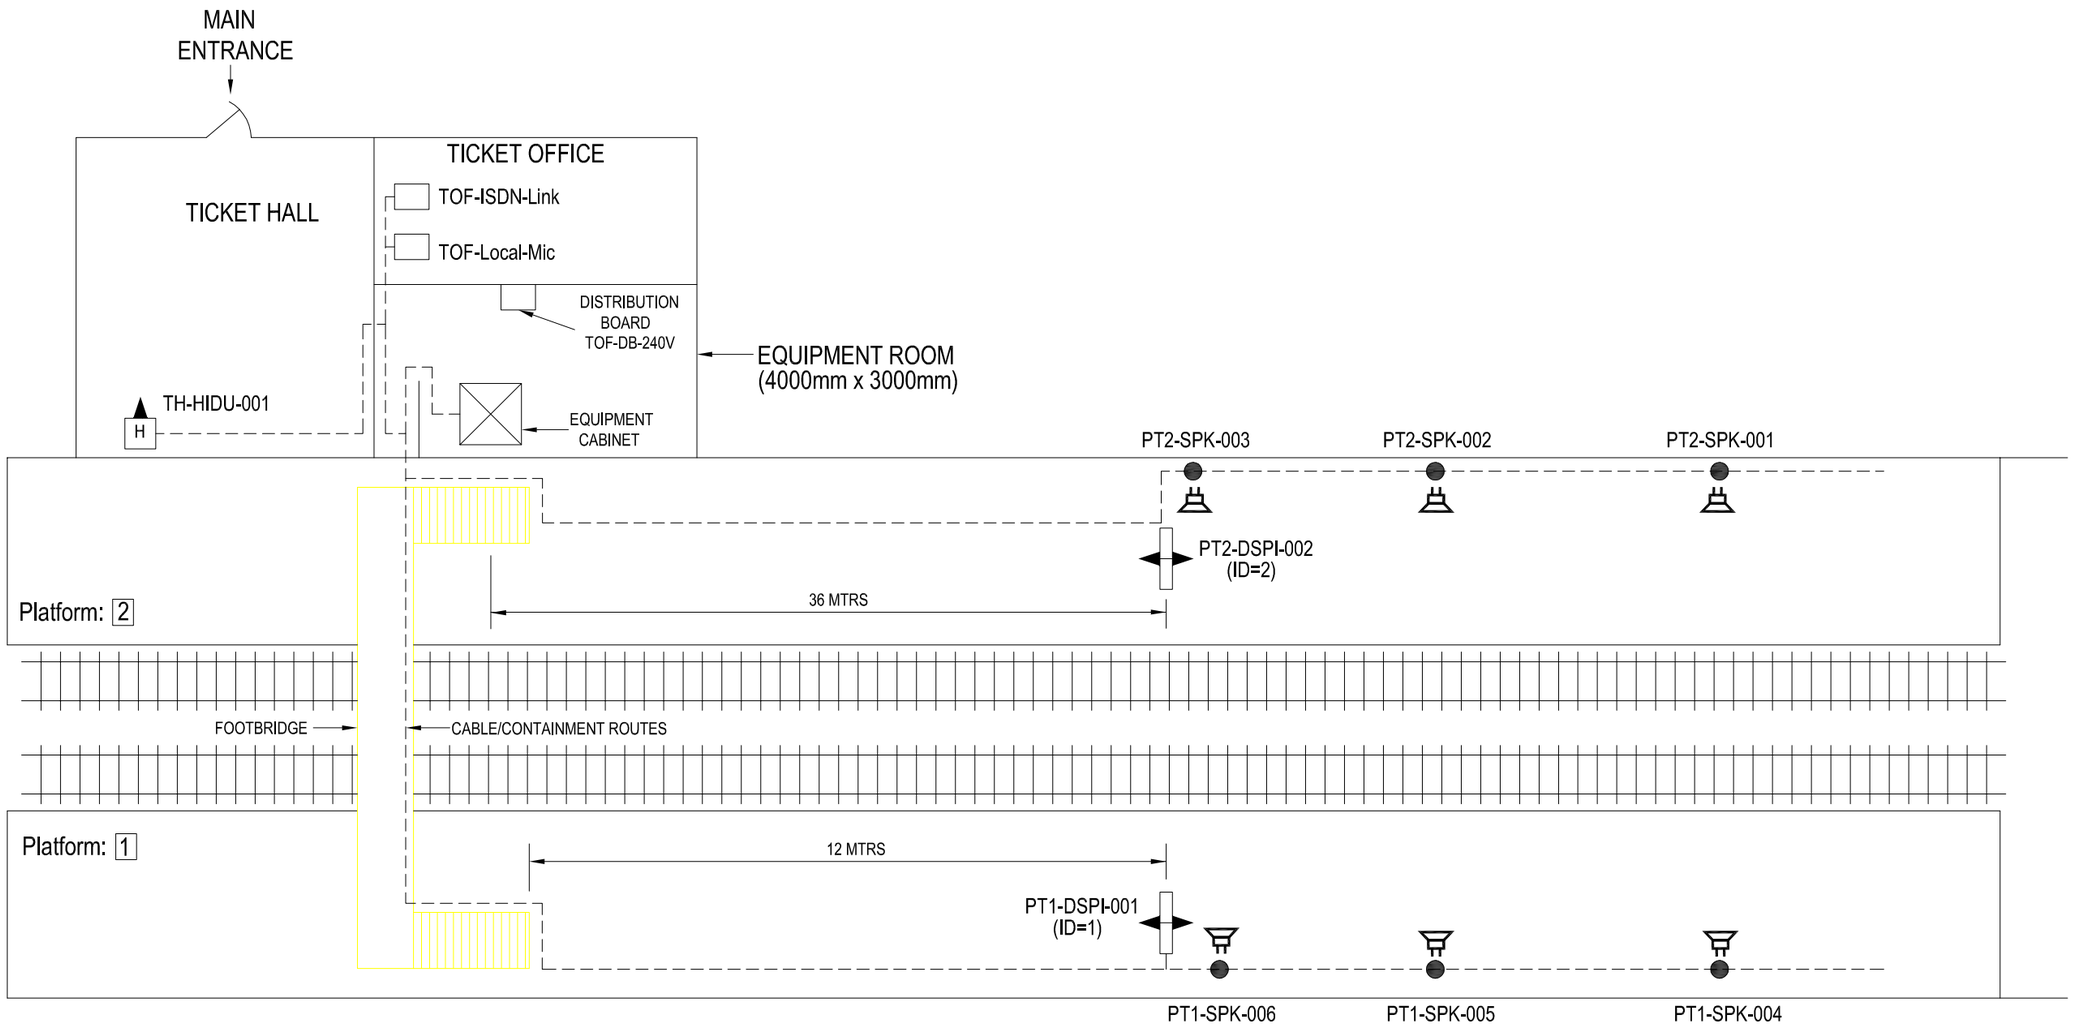

IF IN DOUBT ASK!

MATERIAL	CONSTRUCTION		NAME	SIGNATURE	DATE
		DRAWN BY	D GADDU		11-02-2002
		CHECKED BY			
		APPD BY			
		APPD BY			
FINISH					
		CAD Ref:			
		CONTRACTOR'S Ref:			

AMEY DATEL Project Offices
1st Floor, Platform 2/3
Eastleigh Station
Southampton Road
Eastleigh
Hants
SO50 9FL

COPYRIGHT © AMEY Rail
All rights reserved. Neither this drawing or any of the information it contains may copied or communicated to third parties without the written permission of the copyright holder

SITE/PROJECT: SOUTH WEST TRAINS CIS PROJECT

TITLE: POKESDOWNE AS BUILT

SCALE	DRG No.	ISSUE	SHEET
NTS	SM803-75885	B	1 of 1