DRG No.

SM803-75837

WAN	
CIRCUIT ID	KXIP 600409
IP ADDRESS	10.227.213.1

"PLATFORM 1 HP ISDN"
01-963-370012

All Equipment tags to be prefixed with "TMC-"

Equipment Cabinet

Double Sided LED

Single Sided LED

C 15" Cased Monitor

F 15" Housed Monitor

T 20" TFT Display

H 25" Housed Monitor

P 42" Plasma Display

Loudspeaker

Above Surface Cable Route

Sub Surface Cable Route

LEGEND

Equipment	Dist Board	
CONCENTRATOR	CCT NO. 1	
CIS RACK	CCT NO. 2	
13 AMP TWIN SKT	CCT NO. 3	
LED PT 1	CCT NO. 4	
SPARE	CCT NO. 5	

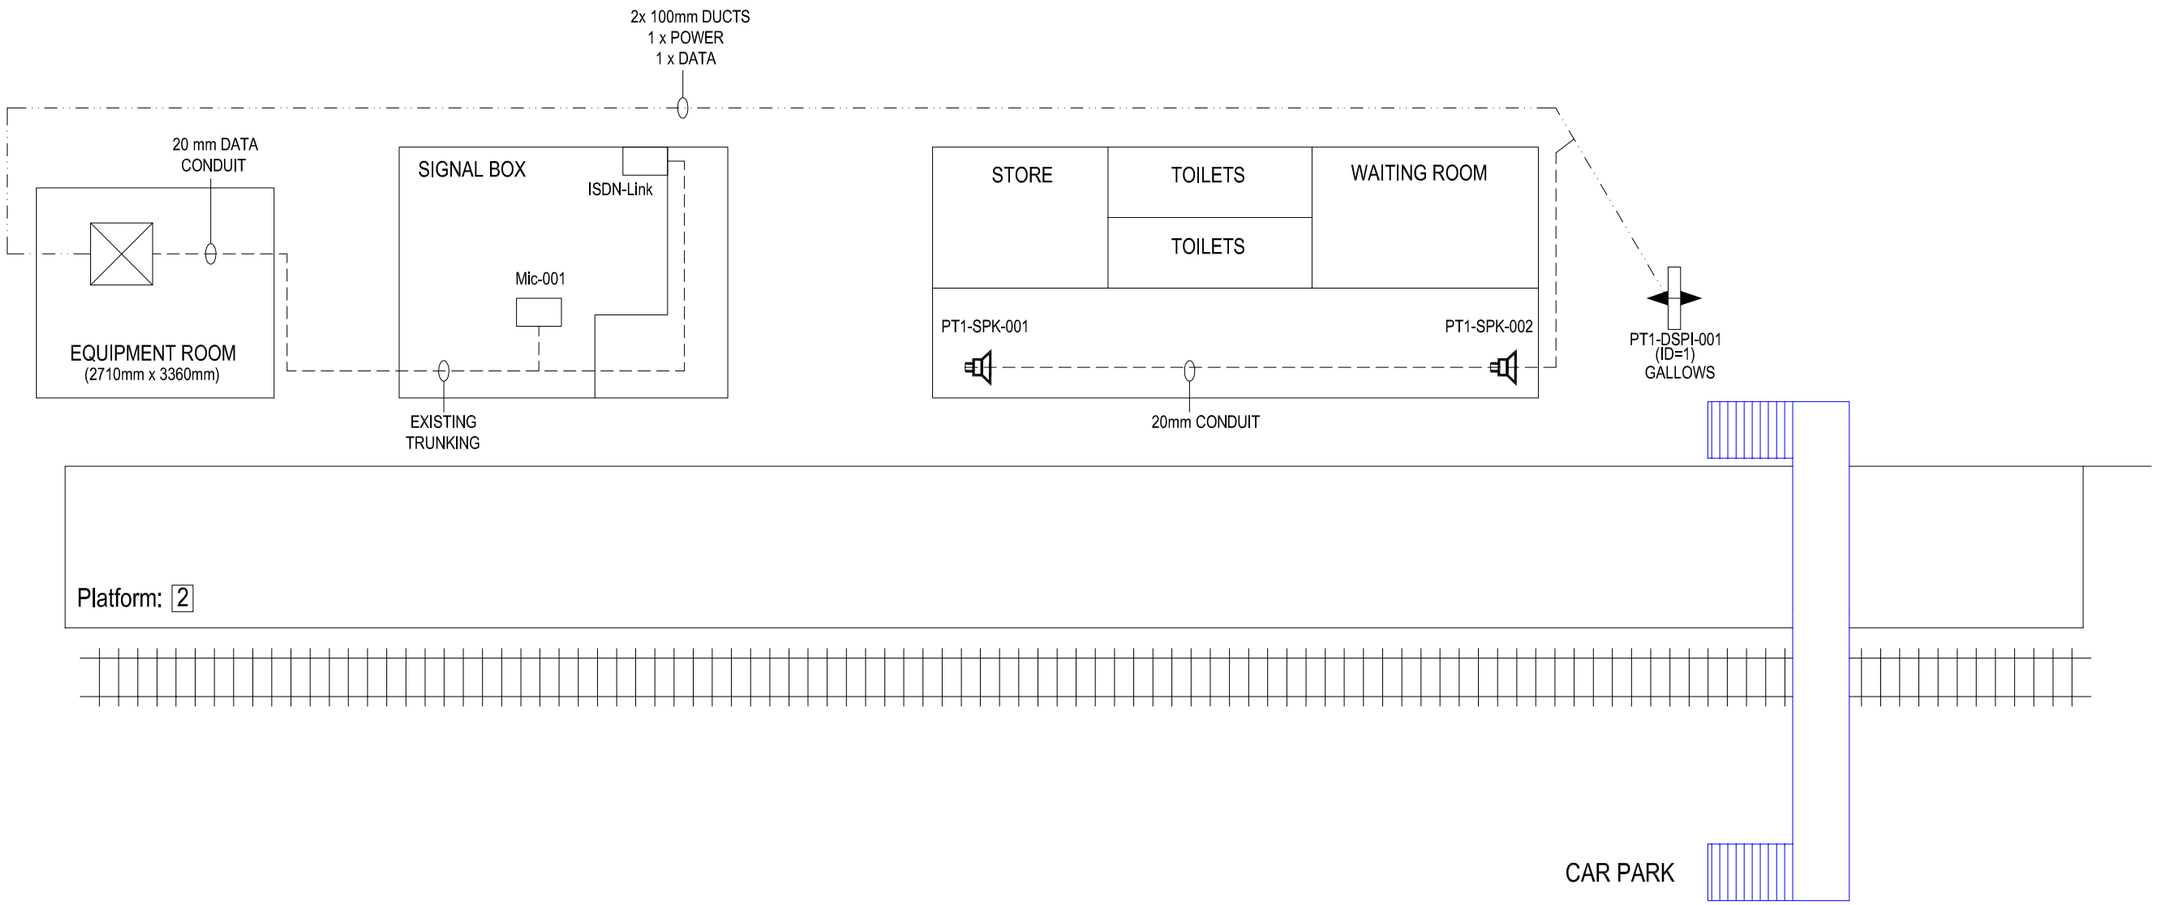

IF IN DOUBT ASK!

MATERIAL

FINISH

CONSTRUCTION

	NAME	SIGNATURE	DATE
DRAWN BY	D GADDU		20-03-2002
CHECKED BY	T WONG		
APPD BY	A SMITH		
APPD BY			

CAD Ref:

CONTRACTOR'S Ref:

AMEY DATEL Project
Offices
1st Floor, Platform
2/3
Eastleigh Station
Southampton Road
Eastleigh
Hants
SO50 9FL

COPYRIGHT © AMEY Rail
All rights reserved. Neither this drawing or any of the information it contains may copied or communicated to third parties without the written permission of the copyright holder

SITE/PROJECT

SOUTH WEST TRAINS CIS PROJECT

TITLE

TEMPLECOMBE
AS BUILT

SCALE	DRG No.	ISSUE	SHEET
NTS	SM803-75837	B	1 of 1